


KANSAS

Barton

Section 22 ~~29~~ Township 19 Range 11-WWell No. #1 IsernCompany ~~I. W. Murfin~~ Threeway Drilling

Laterman pool

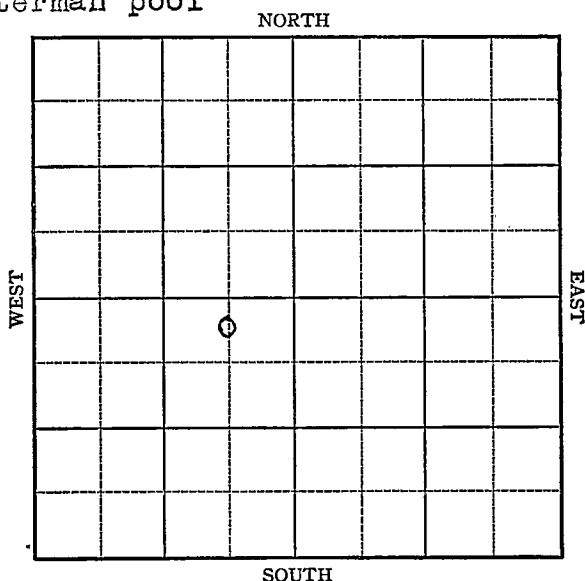

KANSAS


Barton

Sec. 29 22 Twp. 19 R. 11-WWell No. #1 Isern Farm
Threeway Drilling
I. W. Murfin Company

Laterman pool

330 Ft. from N. Line Ft. from S. Line660 Ft. from E. Line Ft. from W. Line

C NL NE SW Elev. 1779

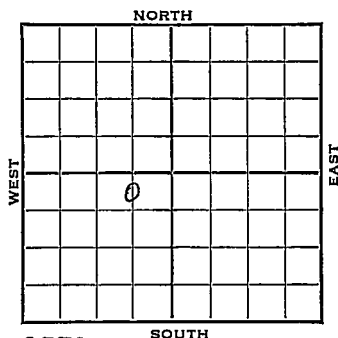

1942

REPORT

12/2

Loc.

12/9

"

12/16

"

12/22

"

12th/29

"

1943

1/6

"

1/13

marked off report

1/20

Cable Rig.

1/27

" "

2/3

8" @ 220'

Anhy 550

Drlg. 1350'

2/10

Lans 3060

Drlg. 3148'

2/17

Arb 3348

TD 3353

5" Casing set 3348 RUST.

OVER

1

1943

2/24 No show 500 acid no show 5 qts
3355-58 bi sgiw 50 shots 3076-
92-1000 acid no show SD

3/3 " " " "

3/10 TD 3366-1500 Acid
700' water 250' oil PB

3/18 PB 3084

3/24 " "

3/31 Lans~3060
Arb 3348
5" @ 3348
500 acid
Pump 50 Pot.
Gr. 40
T.D. 3366'

COMPLETED

Barton

KANSAS 6
Map No. 6 Sec. 29 Twp. 19 R. 11WWell No. 1 IsarnI. W. Murfin Company

FIRST REPORT

Contractor

C NL NE SW

330 Ft. from N. Line

Ft. from S. Line

660 Ft. from E. Line

Ft. from W. Line

SECTION PLAT

	D		

LATERMAN POOL

Location XXX

Rig up

Drilling and Remarks:

RECORD

Cased in., ft.Sand Gas Oil Total Depth

PRODUCTION

1st 24 hrs. Nat. 1st 24 hrs. after shot Gas Cu. Ft.Dry Hole Abandoned

Date

DEC 2 1942 19 S. J. LEWIS Scout

Misc Small Maps *One*
 Cards..... *Box*
 Tracing..... *MB*
 France Map..... *✓*
 Scarborough Map..... *✓*
 Moody Map..... *MB*
 Geological Dept.....
 Moody Flat Book.....

KANSASMap No. 46 Sec. 22 Twp. 19 R. 11WWell No. 1 Isern

I. W. Murfin Company

CORRECTION Contractor

C NL NE SW

330 Ft. from N. Line

Ft. from S. Line

660 Ft. from E. Line

Ft. from W. Line

LANTERMAN POOL

SECTION PLAT

	o		

Location

Rig up

Drilling and Remarks:

Reported as

29-19-11W

RECORD

Cased _____ in., _____ ft.

Sand _____

Gas _____

Oil _____

Total Depth _____

PRODUCTION

1st 24 hrs. Nat. _____

1st 24 hrs. after shot _____

Gas _____ Cu. Ft.


Dry Hole _____

Abandoned _____

Date

JAN 6 1943 19

S. J. LEWIS Scout

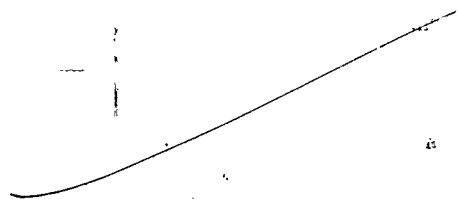

Misc Small Maps	<i>One</i>
Cards	<i>Boat</i>
Tracing	<i>MB</i>
France Map	<i>MB</i>
Scarborough Map	<i>MB</i>
Moody Map	<i>MB</i>
Geological Dept.	
Moody Flat Book	

Barton

KANSAS

Map No. 46 Sec. 22 Twp. 19 R. 11WWell No. 1 Isern

Threeway Drilling Company

CORRECTION Contractor

C NL NE SW

330 Ft. from N. Line

Ft. from S. Line

660 Ft. from E. Line

Ft. from W. Line

SECTION PLAT

	o		

LATERMAN POOL

Location

Rig up

Drilling and Remarks:

Reported as

I. W. Murfin

RECORD

Cased _____ in., _____ ft.

Sand _____

Gas _____

Oil _____

Total Depth _____

PRODUCTION

1st 24 hrs. Nat. _____

1st 24 hrs. after shot _____

Gas _____ Cu. Ft.

Dry Hole _____

Abandoned _____

Date

FEB 3 1943 19 S. J. LEWIS Scout

Misc Small Maps *Cma*

Cards *Boob*

Tracing *ms*

France Map *✓*

Scarborough Map *✓*

Moody Map *ms*

Geological Dept.

Moody Flat Book

KANSAS

Map No. 46 Sec. 22 Twp. 19 R. 11WWell No. 1 IsernThreeway Drilling Company

COMPLETED

Contractor

C NL NE SW

SECTION PLAT

330 Ft. from N. Line

Ft. from S. Line

660 Ft. from E. Line

Ft. from W. Line

	1		
	0		

LATERMAN POOL

Location

Rig up

Drilling and Remarks:

*Lease 3060**Ac 3348**5" @ 3348**500 acid**Pump 50 Pst**405 G*

RECORD

Cased _____ in., _____ ft.

Sand _____

Gas _____

Oil _____

Total Depth 3266

PRODUCTION

1st 24 hrs. Nat. _____

1st 24 hrs. after shot _____

Gas _____ Cu. Ft.

Dry Hole _____

Abandoned _____

Date

MAR 3 1 1943

19

S. J. LEWIS Scout

Misc. Small *Small*
Cards *Madge*
Tracing *Madge*
France Map *Madge*
Scarborough Map *Madge*
Woody Map *Madge*
Geological Dept.
Moody Flat Book