

Section 22 Township 19 Range 11 WWell No. # 1 KindswaterCompany Heathman & Co.

NORTH

					0		

WEST

EAST

SOUTH

Barton

KANSAS

Sec. 22 Twp. 19 R. 11W ✓

Well No. #1 Kindswater Farm

Keathman & Co. Company

Walter Contractor


330 Ft. from N. Line

 Ft. from S. Line

 Ft. from E. Line

990 Ft. from W. Line

NE NW SE

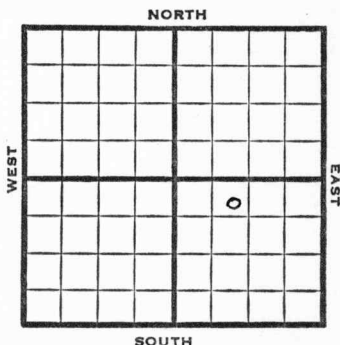

1952 Elev. 1776' REPORT

8/13 Spud 8-9-52
8" @ 190'
Anhy 546'

8/20 Drlg. 1000'
Topeka 2652' Heeb 2920' Tor 2942'
Douglas 2952' Br Li 3037'
Lans. 3058'
DST 3208-42', 1 hr, 15' M Off
Cong. 3330' Circu @ 3334'

8/27 Spud 8-9-52
D&A TD 3400'
8" @ 190'
Anhy 546' Top. 2652
Heeb. 2920 Tor. 2942
Doug. 2952 Br Li 3037
Lans. 3058
DST 3208-42 open 1 hr. rec. 15' mud
Off Cong. 3330 Arb. 3385
TD 3400' D&A

ABANDONED

County **Barton** State **Kansas**

Sec. **22** (Blk.) **19** (Sur.) **11W** Map No.

Operator Heathman & Co.

Well No. **1** Farm **Kindswater**

Elev. 1776 Location NE NW SE

FIRST REPORT

330 Ft. From N Line SE

990	Ft. From	Line	Quarter
-----	----------	------	---------

1st. Report AUG 13 1952

Completion

Remarks

Walter - Contr.

Spudding Date 8-9-52

Drlg. Data

8" © 190 Anhy 546 Drlg. 1000

J. G. McGEHEE

County Barton State Kans
 Sec. 22 (Blk.
Twp.) 19 (Sur.
Rge.) 11W Map No.
 Operator Heathman & Co.
 Well No. 1 Farm Kindswater
 Elev. 1776 Location NE NW SE



330 Ft. From N Line SE
990 Ft. From W Line Quarter

1st. Report

Completion AUG 27 1952

Remarks

Walters Drlg. - Contr.

Spudding Date 8-9-52

Drlg. Data D & A TD 3400

8" @ 190 Anhy 546 Top. 2652

Heeb. 2920 Tor. 2942 Doug. 2952

Br. lime 3037 Lans. 3058 DST 3208-42

open 1 hr. Rec. 15' mud O#

Cong. 3330 Arb. 3385 TD 3400

D & A

J. G. McGEHEE