

KANSAS


FORM 51 5M 4-41 PETROL

Barton

Section 22 Township 19 Range 11-W


Well No. #4 Henning

Company Texas

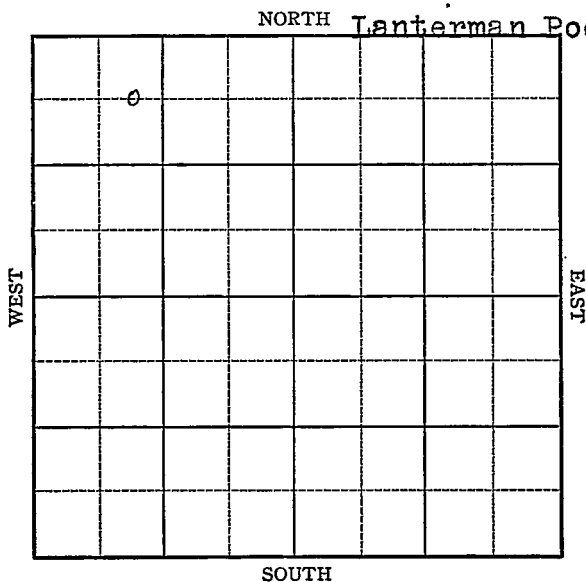

Sec. 22 Twp. 19 R. 11-WWell No. #4 Henning FarmTexas Company
(Lanterman)660 Ft. from N. Line Ft. from S. Line Ft. from E. Line990 Ft. from W. Line

Elev. 1784

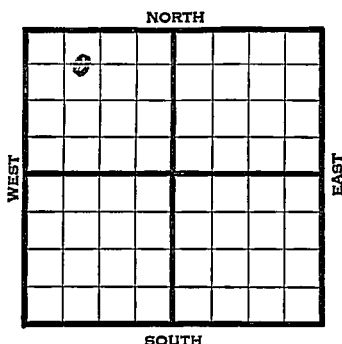

1941	REPORT
7/23	Rotary
7/31	10" @ 253' Drlg. 2270'
8/7	Lansing 3055' TD 3146' 7" @ 3141 RUST
8/15	SSO 3167' 5000 500 acid. Drlg. 3266'
8/21	Arb. 3333' 5" - 3333' T.D. 3357' RUST.
8/28	T.D. 3363½' 1500 acid. 1½ bbls. oil per hour.
9/4	" " " "
9/10	Arb. 3333' 5" - 3333' T.D. 3357' 3500 acid. Potential 53 bbls., pump. 43.2 Gravi ty
	COMPLETED

Map No. _____ Sec. 22 Twp. 19 R. 11WWell No. 4 Henning

_____ Texas _____ Company

FIRST REPORT _____ Contractor

SECTION PLAT

C E L NW NW

0			

660 Ft. from N. Line

_____ Ft. from S. Line

_____ Ft. from E. Line

990 Ft. from W. Line

LANTERMAN POOL

Location _____

Rig up _____

Drilling and Remarks:

Rotary

RECORD

Cased _____ in., _____ ft.

Sand _____

Gas _____

Oil _____

Total Depth _____

PRODUCTION

1st 24 hrs. Nat. _____

1st 24 hrs. after shot _____

Gas _____ Cu. Ft.

Dry Hole _____

Abandoned _____

Date

JUL 23 1941

19

S. J. LEWIS

Scout

Map No. _____ Sec. 22 Twp. 19 R. 11WWell No. 4 Henning

_____ Texas _____ Company

_____ COMPLETED _____ Contractor

C E L NW NW

660 Ft. from N. Line

_____ Ft. from S. Line

_____ Ft. from E. Line

990 Ft. from W. Line

LANTERMAN POOL

SECTION PLAT

Location _____

Rig up _____

Drilling and Remarks:

*Cr 83333**5" @ 3333**3500 acid**Pump 53 P.D.**432 gr*

RECORD

Cased _____ in., _____ ft.

Sand _____

Gas _____

Oil _____

Total Depth 3357

PRODUCTION

1st 24 hrs. Nat. _____

1st 24 hrs. after shot _____

Gas _____ Cu. Ft.

Dry Hole _____

Abandoned _____

Date

SEP 10 194119S. J. LEWISScout