

Section 22 Township 19 Range 11 W

Well No. # 1 Hirsch

Company Alpine Oil & Royalty

NORTH

							0

WEST

EAST

SOUTH

Sec. 22 Twp. 19 R. 11 W ✓

Well No. # 1 Hirsch Farm

Alpine Oil & Royalty Company

Quaker Contractor


990 Ft. from N. Line

Ft. from S. Line

330 Ft. from E. Line

Ft. from W. Line

SE NE NE

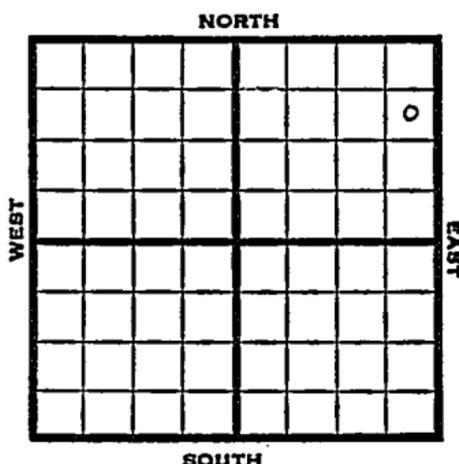

1951

Elev. 1787' REPORT

7/3

Spud 6-29-51
8" @ 225' Anhy 555'
Drlg. 1360'

1952
1/16

Spud 6-29-51
D & A TD 3363' 8" @ 225'
Anhy 555' Heeb 2928' Br lime 3045'
Lans. 3060'
DST 3064-3136' open 1 hr, rec 420'
gas, 38' G & OCM.
DST 3148-60 open 1 hr, rec 15' HOCM
DST 3319-42 open 1/2 hr. rec 3' mud
Cong. 3334' TD 3363' 5" @ 3362'
CO to 3340' 63/3152-63 SSO 500 A
S/5 BWPH PB 3146' 26/3132-38
44/3112-22 500 A 24/3112-19
24/3085-91 water.
D & A

ABANDONED


County Barton State Kansas

Sec. 22 (Blk. 19) (Sur. 11W) Map No.

Operator Alpine Oil & Royalty

Well No. 1 Farm Hirsch

Elev. _____ Location SE NE NE

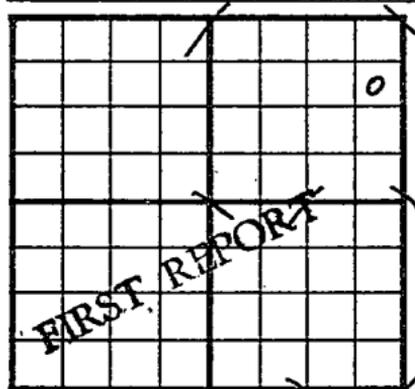

990 Ft. From N Line NE

330 Ft. From E Line _____ Quarter _____

lst. Report JUL 3 1951

Completion _____

Remarks _____

Quaker - Contr.

Spudding Date 6-29-51

Drlg. Data _____

8" @ 225' Any 555' Drlg. 1360

J. E. TYRA


County Barton State Kansas

Sec. 22 (Blk. Twp.) 19 (Sur. Rge.) 11W Map No.

Operator Alpine Oil & Royalty

Well No. 1 Farm Hirsch

Elev. 1787 Location SE NE NE

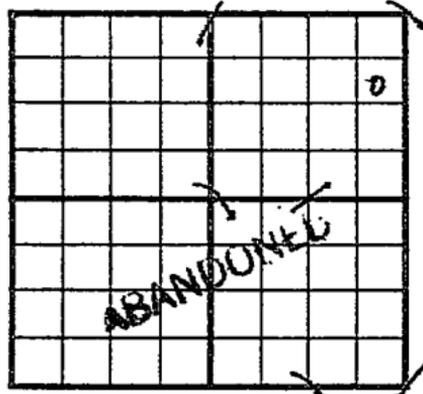

990 Ft. From N Line NE

330 Ft. From E Line Quarter

Ist. Report

Completion JAN 16 1952

Remarks

Quaker Drlg. - Contr.

Spudding Date 6-29-51

Drlg. Data D & A TD 3363

8" @ 225 Anhy 555 Heeb. 2928

Br. lime 3045 Lans. 3060 DST 3064-3136

open 1 hr. Rec. 420' gas 38' g & ocm

DST 3148-60 open 1 hr. Rec. 15' hoem

DST 3319-42 open 1/2 hr. Rec. 3' mud

Cong. 3334 TD 3363 5" @ 3362

CO to 3340 63/ 3152-63 SSO 500 A

S/ 5 bwph PB 3146 26/ 3132-38

44/ 3112-22 500 A 24/ 3112-19

24/ 3085-91 water

D & A