

Section 22 Township 19 Range 11W

Well No. #2
#5 Isern

Company W. L. Hartman

NORTH

W							

WEST

EAST

SOUTH

Sec. 22 Twp. 19 R. 11W

Well No. #2 Isern Farm

W. L. Hartman Company

W. L. Hartman Contractor


330 Ft. from N. Line

Ft. from S. Line

Ft. from E. Line

330 Ft. from W. Line

NW NW SW

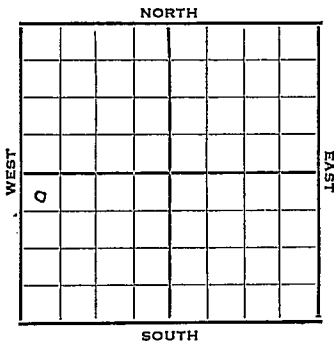

1952 Elev. 1781' REPORT

6/18 Spud 6-14-52
8" @ 182'
Anhy 570'
Drlg. 2010'

6/25 Lans. 3068
DST 3156-62, 1/2 hr. 12' ocm
DST 3238-50, 1 1/4 hr. 62' ocm
900# Arb. 3346-80 RTD
5" @ 3380'

7/2 NR

7/9 36/3346-52 S/36 BO 12 hrs. POP

7/17 NR

7/23 "

7/30 "

8/6 "

8/13 "

8/20 "

8/27 "

9/3 "

9/10 "

9/17 "

9/24 Spud 6-14-52
Oil Well TD 3380' 8" @ 182'
Anhy 570 Lans. 3068
DST 3156-62 open 1/2 hr. rec. 12' ocm

OVER

1952

9/24 DST 3238-50', open $1\frac{1}{4}$ hr. rec. 62' ocm
900# Arb. 3346 TD 3380'
5" @ 3380' 36/ 3346-52 S/ 36 bo
12 hr. Comp. 50 bopd

COMPLETED

County **Barton** State **Kansas**

Sec. **22** (Blk. Twp.) **19** (Sur. Rge.) **11W** Map No.

Operator **W. L. Hartman**

Well No. **1** Farm **Isern**

Elev. Location **NW NW SW**

FIRST REPORT

330 Ft. From **N** Line **SW**

330 Ft. From **W** Line Quarter

Ist. Report **JUN 18 1952**

Completion

Remarks
W. L. Hartman

Spudding Date **6-14-52**

Drlg. Data
8" @ 182 Anhy 570 Drlg. 2010

Scott Cards

Land Small Map

Land Wall Map

Tracings

France Map

Pierce Map

MISC.

JUN 20 1952

Orig. Data

Scout Cards
Land Small Map
Land Wall Map
Tracings
France Map
Pierce Map
Misc.

SEP 30 1952

Orig. Data

Map No. _____ Sec. 22 Twp. 19 R. 11W

Well No. 2 Isern

W. L. Hartman Company

Contractor

NW NW SW

SECTION PLAT

330 Ft. from N. Line

_____ Ft. from S. Line

_____ Ft. from E. Line

330 Ft. from W. Line

0			

RECORD

Location _____

Cased _____ in., _____ ft.

Rig up _____

Sand _____

Drilling and Remarks:

Gas _____

Reported

Oil _____

1

Total Depth _____

PRODUCTION

1st 24 hrs. Nat. _____

1st 24 hrs. after shot _____

Gas _____ Cu. Ft.

Dry Hole _____

Abandoned _____

Date

JUL 2 1952

J. G. McGEHEE


19

Scout

1000



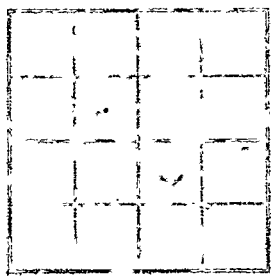















