

KANSAS

FORM 51 5M 4-41 PETROL

Barton

O. W. D. D.

Section 22 Township 19 Range 11-W

Well No. #2 Henning #1 Rhem (SWD Unit)


Company Texas Lario (Texas)

Lanterman Pool

NORTH

WEST

EAST

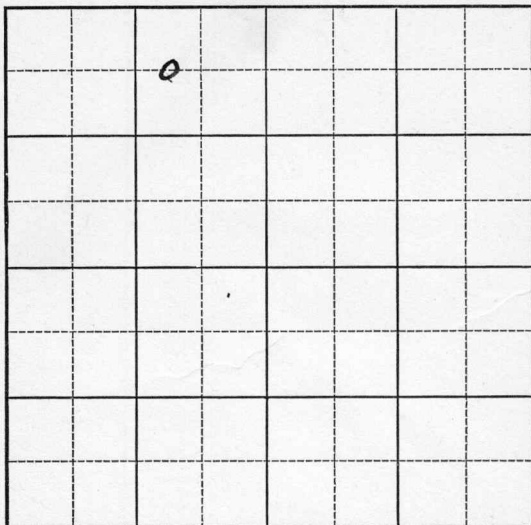

SOUTH

KANSAS

Barton

Sec. 22 Twp. 19 R. 11-WWell No. #2 Henning Farm


Texas

Company

(Lan terman)

660 Ft. from N. Line Ft. from S. Line990 Ft. from E. Line Ft. from W. Line

Elev. 1781

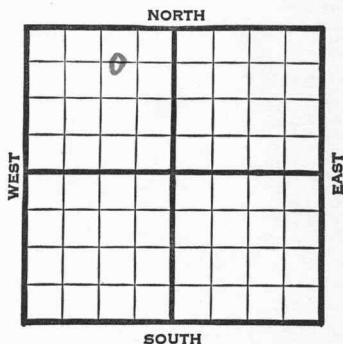

1941

REPORT

5/7 Location

5/15 "

5/22 Rotary.

5/28 10" - 313' Drlg. 2430'

6/5 Lans. 3063' Arb. 3336-41' T.D.

7" - 3337' RUST.

6/12 T.D. 3348½' S.S.O.

6/19 9 shots 3136-62' 1000 acid.

Testing.

6/25 Lans. 3063'

Arb. 3336'

7" - 3337'

T.D. 3348½'

9 shots 3136-62.

4000 acid.

Depthograph potential 4604 bbls.

Maximum 3000 bbls.

43.5 Gravity

COMPLETED

Map No. 46 Sec. 22 Twp. 19 R. 11WWell No. 2 Henning

Texas

Company

FIRST REPORT

Contractor

C W L NE NW

SECTION PLAT

660 Ft. from N. Line Ft. from S. Line990 Ft. from E. Line Ft. from W. Line

LANTERMAN POOL

Location XRig up

Drilling and Remarks:

RECORD

Cased in., ft.Sand Gas Oil Total Depth

PRODUCTION

1st 24 hrs. Nat. 1st 24 hrs. after shot Gas Cu. Ft.Dry Hole Abandoned

Date

MAY 7 1941 19

S. J. LEWIS

Scout

Map No. _____ Sec. 22 Twp. 19 R. 11WWell No. 2 Henning

_____ Texas _____ Company

_____ **COMPLETED** _____ Contractor

C W L NE NW

660 Ft. from N. Line

_____ Ft. from S. Line

990 Ft. from E. Line

_____ Ft. from W. Line

LANTERMAN POOL

SECTION PLAT

	•		

Location _____

Rig up _____

Drilling and Remarks:

4 am 3063
Cr 8336
7" @ 3337
9 Blk to 3136 - 62.
4000 aciol
Depth 284604
Max 3000

RECORD

Cased _____ in., _____ ft.

Sand _____

Gas _____

Oil _____

Total Depth 3348 1/2

PRODUCTION

1st 24 hrs. Nat. _____

1st 24 hrs. after shot _____

Gas _____ Cu. Ft.

Dry Hole _____

Abandoned _____

435 Gr.

Date

JUN 25 1941

19

S. J. LEWIS

Scout

FORM 513 SUNRAY

Co.

Use

Sec

1

ス

County Barton Elev. 1781
 Sec. 22 Twp. 19 Rge. 11W
 Company Lario (Texas)
 Farm Name Rhem SWD Unit No. 1

TOPS	DEPTH	LOG	DATUM	Loc. in Sec.
Anh.				W/2 NE NW
Tp.				OWDD for SWD
H.				
Tr.				
Dg.				
Bl.				
L.				Geol.
K.C.				Cantr.
B.K.C.				Buick Drlg.
Ce.				
C.				Pool
M.				Lantermen
M.				
K.				
Mz.				
Mq.				
V.				
S.				
S.				
A				
R.				
Pe.				
G.				
TD	3791			

ABANDONED

Date Comm.

Old. inf. Arb 3336, OTD 3348, 7" @ 3337,

New Info. 5" liner @ 3392, WOC DEC 5 '56

CO 3791 input 260 Bwph,
 comp. for SWD well