


Section 22 Township 19 Range 12W

Well No. 1 Christophe

Company Trans-Era

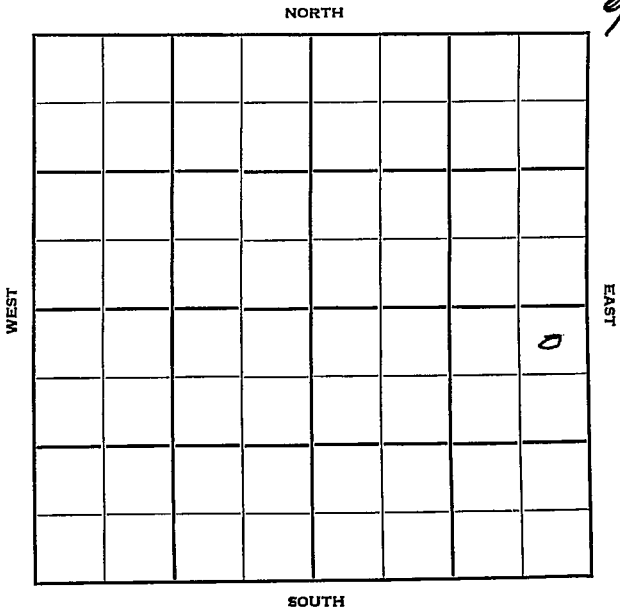



Sec. 22 Twp. 19 R. 12 W

Well No. # 1 Christophe Farm

Trans-Era Company

N. Hammer Pool Contractor


330 Ft. from N. Line

Ft. from S. Line

330 Ft. from E. Line

Ft. from W. Line

NE NE SE

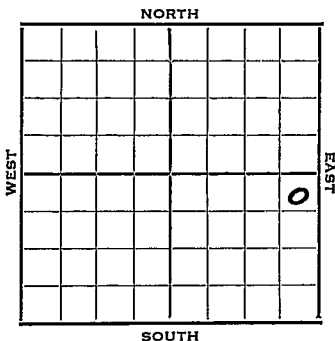

1952 Elev. 1826' REPORT

12/3 Drlg. 1600'

12/11 10" @ 183 Anhy 652 Heeb 2997 Ø3058

12/18 Br 1 3112 Lans 3132 DST 3160-90 1 Hr. 10'
M DST 3268-88 40 Mins 50' M 600# ARB
3390 RTD 332 5" set RUST

12/25 " " " "

1/1 NR

1/8 D&A

1/23 spud 11-28-52

D&A

TD 3422

10" @ 183

Anhy 652, Heeb 2997, Br lime

3112, Lans 3132

DST 3160-90, opn 1 hr., rec.

10' mud 0#

DST 3268-88, opn 40 mins., rec.

50' mud, 600#

Arb. 3390

TD 3392

7" @ 3392

GO to 3392, DD 3400 500A

DD 3414 500A

S/8 goph 1000A S/wtr & scum

oil FU 2200' wtr. DD 3422 HF

D&A

ABANDONED

