


Section 22 Township 19 Range 12-W

Well No. #1 Petz

Company Henderson Oil

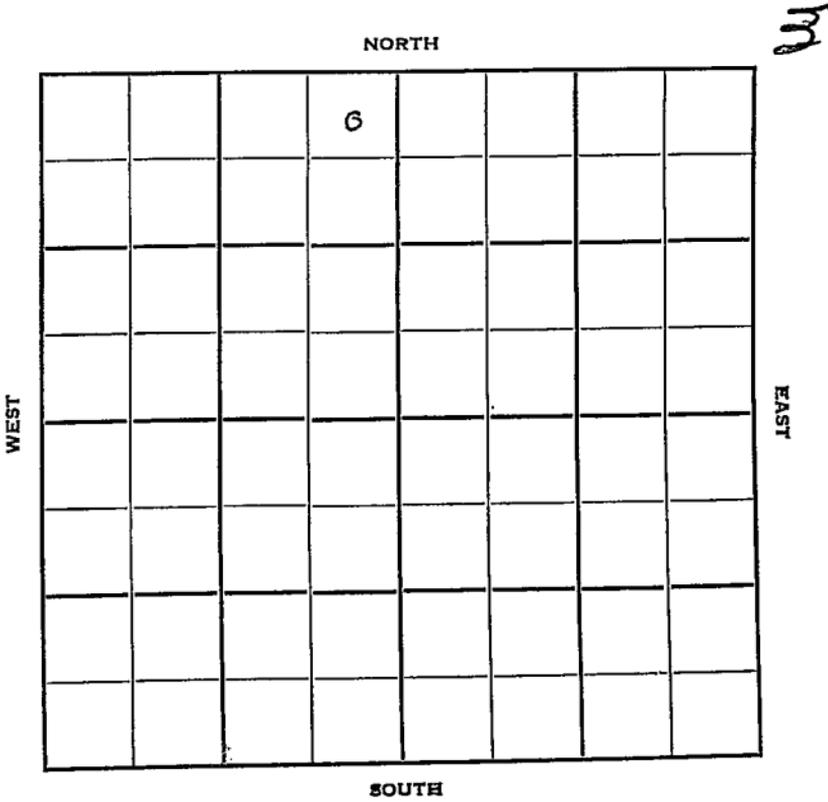

Barton

KANSAS  
12W

Sec. 22 Twp. 19 R. 12W

Well No. #1 Petz Farm

Henderson Oil Company


Semi-Wildcat Contractor

330' Ft. from N. Line

\_\_\_\_\_ Ft. from S. Line

330' Ft. from E. Line

\_\_\_\_\_ Ft. from W. Line

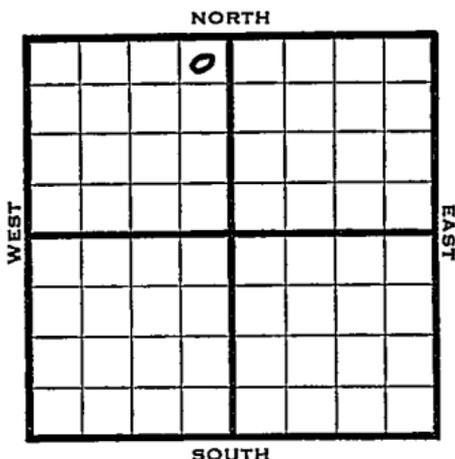

NE NE NW

1950 Elev 1871 REPORT

8/16 8" @ 256'  
WOC

9/20 Spud 8-13-50  
8" @ 256  
Heeb 3046 Br lime 3163  
Lans 3179  
SSO 3182-85 3320-23  
DST 3308-25 opn 1/2 hr rec 5' mud  
Cong 3438-45 Arb 3462-70  
5" @ 3463  
TD 3532 S/30 bwph PB 3376  
56/3351-59 1000 A S/12 bwph PB 3344  
24/3333-41, 15/3320-25  
750 A S/1/2 bwph PB 3215, 14/3196-3201  
PB 3191 15/3182-87  
500 A  
TD 3532  
D&A  
**ABANDONED**


County Barton State Kansas

Sec. 22 (Blk. Twp.) 19 (Sur. Rge.) 12W Map No.

Operator Henderson Oil

Well No. 1 Farm Petz

Elev. \_\_\_\_\_ Location NE NE NW

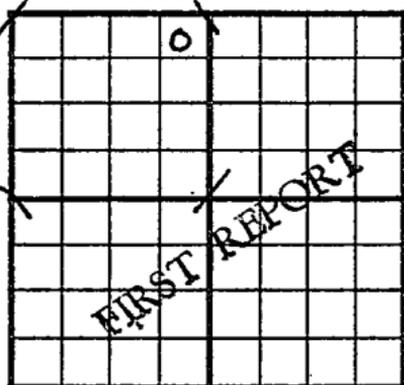

530 Ft. From N Line NW

330 Ft. From E Line Quarter

Ist. Report AUG 16 1950

Completion \_\_\_\_\_

Remarks \_\_\_\_\_

Spudding Date 8-13-50

Drlg. Data Semi Wildcat

8" @ 256 WOC

County Barton State Kansas

Sec. 22 (Blk. Twp.) 19 (Sur. Rge.) 12W Map No.

Operator Henderson Oil

Well No. 1 Farm Petz

Elev. 1871 Location NE NE NW


ABANDONED

330 Ft. From N Line NW

330 Ft. From E Line Quarter

Ist. Report ~~SEP 20 1950~~

Completion SEP 20 1950

Remarks

Semi Wildcat

Spudding Date 8-13-50

Drig. Data D & A TD 3532

8" @ 256 Heeb. 3046 Br. lime 3163

Lens. 3179 SSO 3182-85 3320-23

DST 3308-25 open 1/2 hr. Rec. 5' mud

Cong. 3438-45 Arb. 3462-70 5" @ 3463

TD 3532 S/ 30 bwpd PB 3376 56/ 3351-59

1000 A S/ 12 bwph PB 3344 24/ 3333-41

15/ 3320-25 750 A S/ 1/2 bwph PB 3215

14/ 3196-3201 PB 3191 15/ 3182-87

500 A D & A