

Sec. 22 Twp. 19 R. 12W

Well No. #1 Christopher Farm

Bay Pet. Company

Pickrell - Contr. Contractor

Wildcat


Ft. from N. Line

330' Ft. from S. Line

990' Ft. from E. Line

Ft. from W. Line

SW SE SE

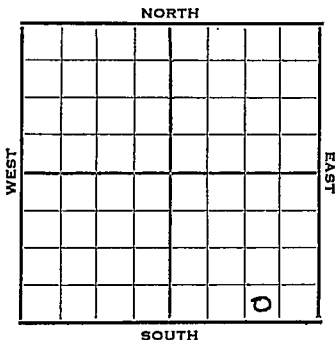

1951 Elev. 1818' REPORT

11/28 Spud 11-25-51
8" @ 193
WOC

12/12 Spud 11-25-51
D&A TD 3433
8" @ 193
Anhy 635 Lans 3114
DST 3115-48 opn 45 min. Rec. 25' mud
DST 3148-87 opn 1 hr Rec. 55' swcm
DST 3245-64 opn 45 min Rec. 10' mud
DST 3269-98 opn 1 hr Rec. 90' mud
60' watery mud
Cong. 3371 Arb. 3433 TD 3433 D&A

ABANDONED


County Barton State Kansas

Sec. 22 (Blk. Twp.) 19 (Sur. Rge.) 12W Map No.

Operator Bay Petroleum

Well No. 1 Farm Christopher

Elev. 1818 Location SW SE SE

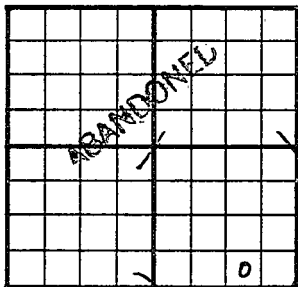

330 Ft. From S Line SE

990 Ft. From E Line Quarter

Ist. Report

Completion DEC 1 2 1951

Remarks Wildcat

Pickrell Drlg. - Contr.

Spudding Date 11-25-51

Drlg. Data D & A TD 3433

8" @ 193 Anhy 635 Lans. 3114

DST 3115-48 open 45 min. Rec. 25' mud

DST 3148-87 open 1 hr. Rec. 55' swcm

DST 3245-64 open 45 min. Rec. 10' mud

DST 3269-98 open 1 hr. Rec. 90' mud

60' watery mud Cong. 3371 Arb. 3433

TD 3433 D & A