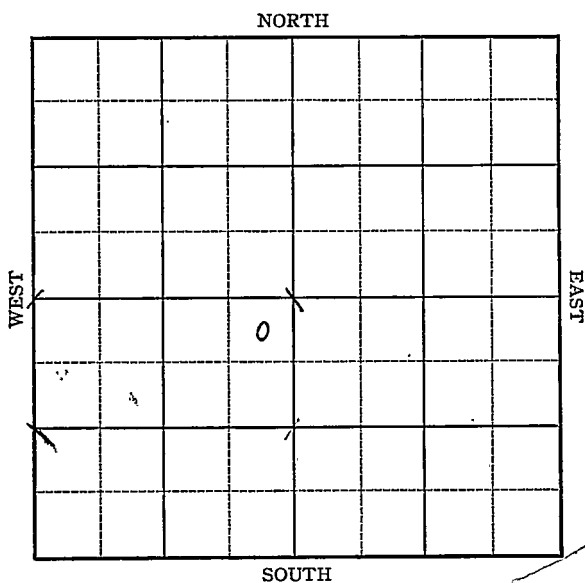


KANSAS

O.W.W.O.

FORM 51 5M 1-42 PETROL

Rice

Section 22 , Township 19 Range 10-WWell No. #1 Bowman "A"Company Stanolind

KANSAS

Rice

Sec. 22 Twp. 19 R. 10-W

Well No. #1 Bowman "A" Farm

Stanolind Company

Silica


330 Ft. from N. Line

 Ft. from S. Line

330 Ft. from E. Line

 Ft. from W. Line

Elev. 1749

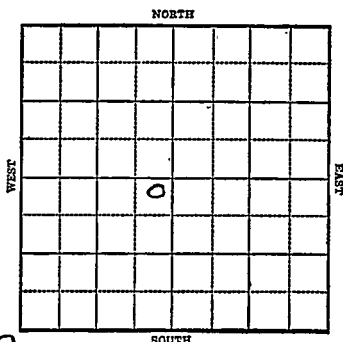

1943

R E P O R T

6/30 Derrick

7/7 8" @ 210'

Drlg. 930'

7/15 Drlg. 2940'

Anhy 447

7/21 Lans 2965

Rework Arb 3277

T.D. 3303

7/28 ARB 3290

5" @ 3290'

Rust

8/4 T.D. 3301 no shows to shoot

8/11 10 qts 3291-3301-1500 acid
swab 15 oil per hr 4 hrs.

8/18 2000 acid swab 5 oil & 15 bbls
WPH 9 hrs.

8/25 " "

9/2 " "

9/8 " "

OVER

1943

9/15 Arb 3290

5" @3290

3500 acid

Pump 250 oil & 250 water Pot.

T.D. 3301

Gravity 43.2

COMPLETED

O.W.W.O.

1951

1/24 OTD 3301 SP 3265' 32/3040-48

1/31 Oil well TD 3265

OTD 3301 SP 3265 32/3040-48

4000 A P/ 60 bo 30 bw pd

Comp. 36 bo 24 bwpd

COMPLETED

County Rice State Kansas

Sec. 22 (Blk. Twp.) 19 (Sur. Rge.) 10W Map No.

Operator Stanolind

Well No. 1 Farm J. Royman "A"

Elev.	1749	Location	NE SW
-------	------	----------	-------

330 Ft. From N Line SW

330 Ft. From E Line Quarter

1st. Report JAN 24 1951

Completion

Remarks (**CHITTO**)

Spudding Date:

Drig. Data

OTD 3301 SP 3265 32/ 3040-48

J. E. TYRA

5111 57 1971

Scout Cards	
Land Small Map	
Land Wall Map	
Tracings	
France Map	
Pierce Map	
Misc.	

Rice

KANSAS
 Map No. 7 Sec. 22 Twp. 19 R. 10W

Well No. 1 BowmanStanolind


Company

FIRST REPORT

Contractor

NE SW

SECTION PLAT

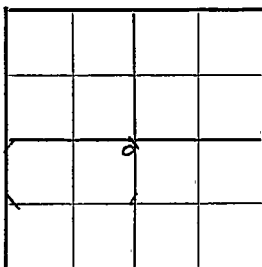330 Ft. from N. Line Ft. from S. Line330 Ft. from E. Line Ft. from W. LineSILICA POOLLocation Rig up

Drilling and Remarks:

RECORD

Cased in. ft.Sand Gas Oil Total Depth

PRODUCTION

1st 24 hrs. Nat. 1st 24 hrs. after shot Gas Cu. Ft.Dry Hole Abandoned Derrick

Date

JUN 30 1943 19S. J. LEWIS Scout

Misc. Small Maps
Cards
Tracing
France Map
Scarborough Map
Moody Map
Geological Dept.
Moody Flat Book

KANSASMap No. 46 Sec. 22 Twp. 19 R. 10WWell No. 1 BowmanStanolind

Company

COMPLETED

Contractor

NE SW

SECTION PLAT

330


Ft. from N. Line

Ft. from S. Line

330

Ft. from E. Line

Ft. from W. Line

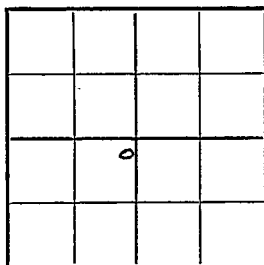Silica Pool

Location

Rig up

Drilling and Remarks:

*Per 3290**5' @ 3290**8000 acid**Pump 2500 oil +**250 Water Per**432 Gr*

RECORD

Cased _____ in., _____ ft.

Sand _____

Gas _____

Oil _____

Total Depth 3301

PRODUCTION

1st 24 hrs. Nat. _____

1st 24 hrs. after shot _____

Gas _____ Cu. Ft.

Dry Hole _____

Abandoned _____


Date

SEP 15 1943

19

S. J. LEWIS

Scout

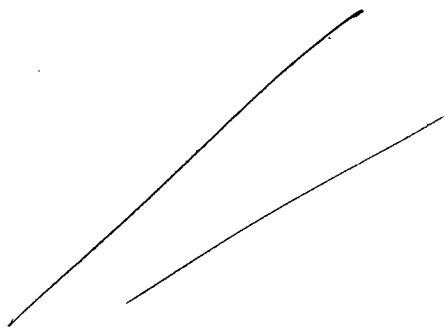


Scout Cards

FEB 5 1951

Land & Trail Map

Land Wall Map

Tracings

France Map

Pierce Map

Misc

Drig. Data