


SECTION 22 TOWNSHIP 19S RANGE 10W

WELL NO. #1 Dupont

COMPANY J-S-F

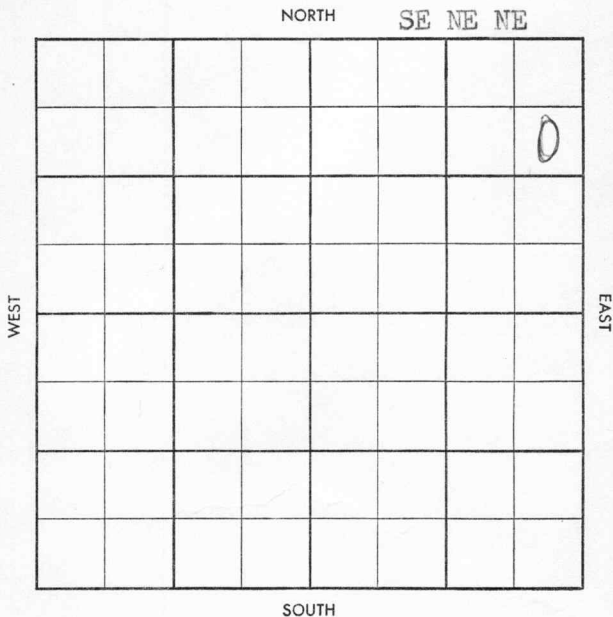

CO. Rice ELEV. 17111
SEC. 22 TWP. 19 RGE. 10W
COMPANY J-S-3 NO. 1

MAR 12 '58

COMPLETE

FARM Dupont
LOC. SE 1/4 N.

Deep 2304
or 2326
Long sh 2339
Long sd 2355
BL 2927
L 2952
BK 3223
C 3263
Arb 3266
TD 3270

GEOL.
CONTR. Dutch Drll.
POOL Chase-Silica
SPUD 11/30/57
5" @ 210 1/200 DST
2846-69, 60" 15' 1. BH
Q DST 3021-30 60' 35'
3000 0' 20', SHP 370
DST 3133-63 30" 15' 1.
SH 610/20, DrL. 2175.

Tops DST 3262-70
60" 1300' gip 20' froggy oil
180' gssy oil BHP 430/20" Arb
3266 RTD 3270 5 1/2" 3267/100
woct DEC 26 '57 CO 3270

TD $\frac{1}{2}$ and tsted 1 1/2 Boph
now^{with} mentioned, $\frac{1}{2}$ tst
 $\frac{1}{2}$ Boph Δ NO increase
T & R wo pump
JAN 22 '58 TD 3280 PB 3230

10/3026-29 10/3037-40
20/3043-44 1500A Δ BW
p h 59 JAN 20 '58 CC 24/3064
70 1500A Δ 1 1/2 B F Ph
5070 AW POP FEB 12 '58

FEB 12 '58 FEB 19 '58 MAR 5 '58 MAR 12 '58

P 6 BOPd + AW

Lsg 3064-70
~~3064~~

CO
LSE
NO.
SEC.
TWP.
RGE.