


Section 22 Township 19 Range 10-W

Well No. #1 Bowman

Company Lewis Drlg.

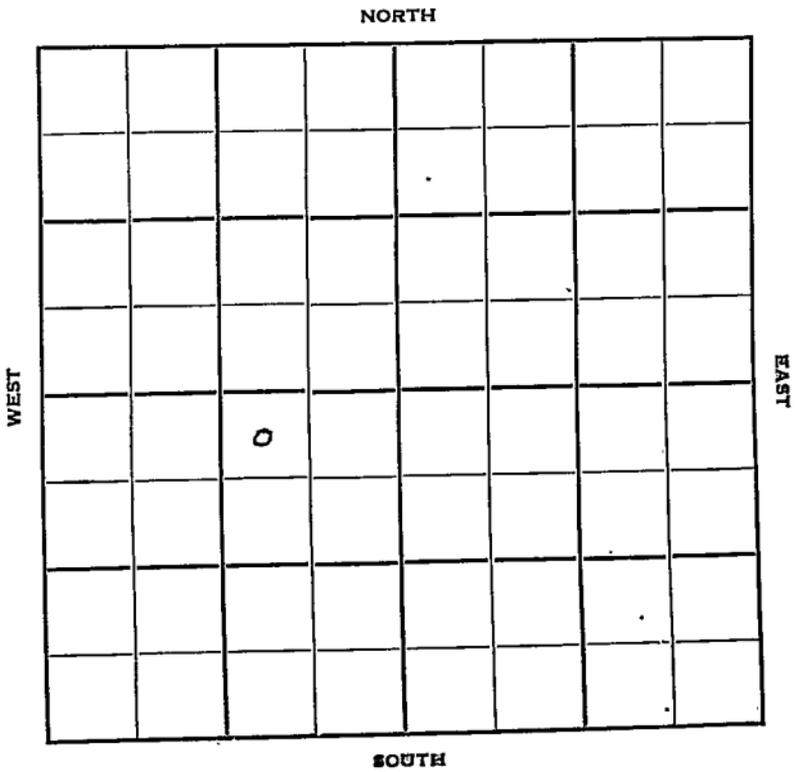

Rice  
19

KANSAS  
10W

Sec. 22 Twp. \_\_\_\_\_ R. \_\_\_\_\_

Well No. #1 Bowman Farm \_\_\_\_\_

Lewis Drlg. Company \_\_\_\_\_

Contractor \_\_\_\_\_

Silica


330' Ft. from N. Line

\_\_\_\_\_ Ft. from S. Line

990' Ft. from E. Line

\_\_\_\_\_ Ft. from W. Line

NW NE SW

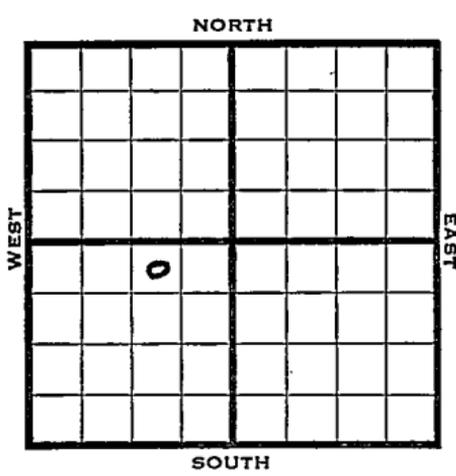

1950 Elev 1752 REPORT

8/23 RUR

9/20 Spud 8-21-50  
 8 5/8" @ 188  
 Anhy 450  
 Dodge 2833  
 KC 2970  
 SO 3043-56  
 Arb 3276-83  
 5" @ 3277  
 TD 3283  
 S 7/2" boph 500 A no Inc.  
 DD 3288  
 D 3300 HFW  
 D&A

Heeb 2815  
 Br lime 2936

**ABANDONED**



Scout Cards .....

Land Small Map .....

Land Wall Map .....

Tracings .....

France Map .....

Pierce Man .....

MISC. ....

*Handwritten scribbles and a large number '3' over the map items.*

**AUG 25 1960**



Scout Cards

Scout Cards

Land Small Map

Land Wall Map

Tracings

France Map

Pierce Map

Misc.

765

3

SEP 25 1959

Orig. Data