


KANSAS Rice County

FORM 51 5M PETROL

Section 22 Township 19 Range 10W

Well No. 1 Katterjohn

Company Phil-Han

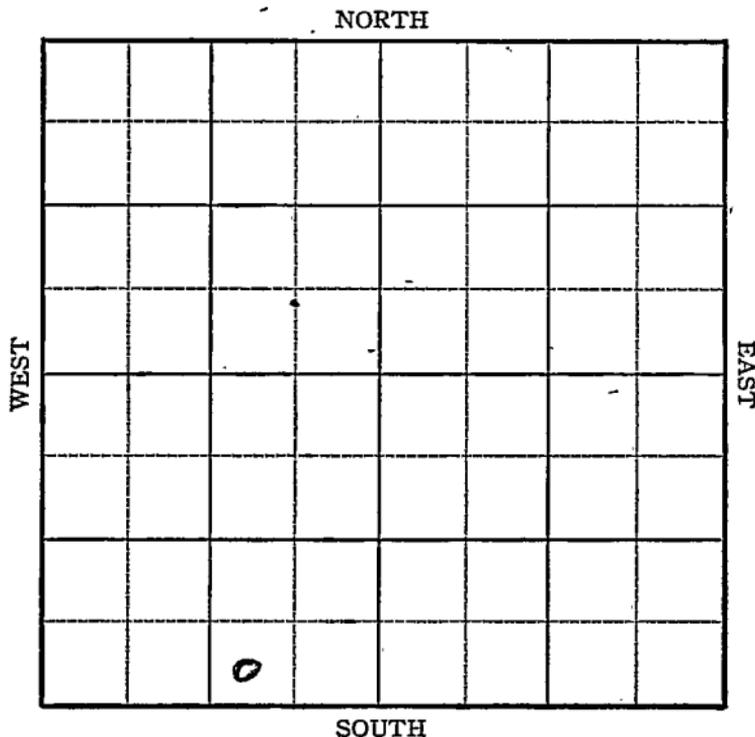

KANSAS

Rice

Sec. 22 Twp. 19 R. 10~~W~~

Well No. #1 Katterjohn Farm

Phil-Han Company


Silica

_____ Ft. from N. Line

330 Ft. from S. Line

990 Ft. from E. Line

_____ Ft. from W. Line

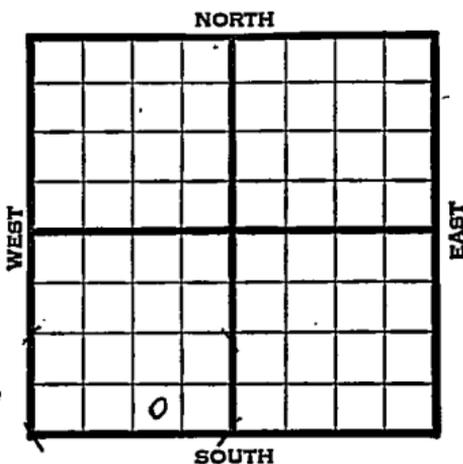

SW SE SW

Elev. 1755

REPORT

1945

7/3

RUR

7/11

8" @ 170

Drig. 2750'

8/19

Arb. 3281-3284

TD 3284' SSO

5" @ 3281' RUST

7/25

Arb. 3281

5" @ 3281

TD 3307'

ABANDONED

