

Rice


FORM 51 5M 10-41 PETROL

KANSAS

Section 22 Township 19 Range 9-W

Well No. #2 Murphy

Company Lauck & Moncrief

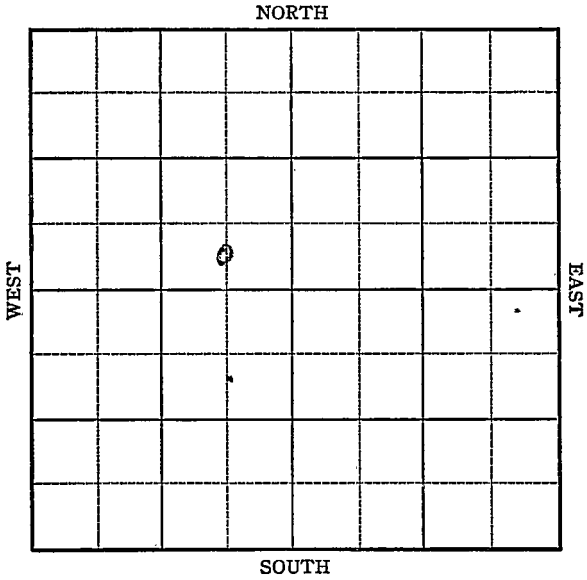

Sec. 22 Twp. 19 R. 9-W

Well No. #2 Murphy Farm

Lauck & Moncrief Company

(Chase)


_____ Ft. from N. Line

330 Ft. from S. Line

660 Ft. from E. Line

_____ Ft. from W. Line :

Elev. 1689

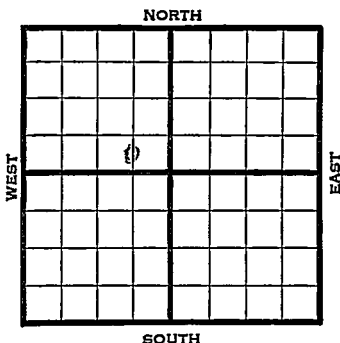

1941	REPORT
11/19	Location
11/28	10" - 120'
	SD 1185'
12/4	Dr1g. 2640'
12/11	Art. 3212-13
	TD. 5" @ 3210 RUST
12/18	Arb 3209
	5" @ 3209 TD 3217 swb. 4 oil per hour.
1/15	TD 3217' SD.
1/22	" "
1/28	Arb. 3209'
	5" - 3209'
	T.D. 3219'
	1000 acid.
	Depthograph potential 1513 bbls.
	45. Gravity
	COMPLETED

Map No. 17-49 Sec. 22 Twp. 19 R. 9WWell No. 2 MurphyLauck & Moncrief CompanyFIRST REPORT Contractor

C SL SE NW

SECTION PLAT

 Ft. from N. Line330 Ft. from S. Line660 Ft. from E. Line Ft. from W. Line

CHASE POOL

Location XXRig up

Drilling and Remarks:

RECORD

Cased in., ft.Sand Gas Oil Total Depth

PRODUCTION

1st 24 hrs. Nat. 1st 24 hrs. after shot Gas Cu. Ft.Dry Hole Abandoned

Date

NOV 19 1941 19S. J. LEWIS Scout

1914

1 7



J 26 1

1 2 19

1 2 19

1 2 19

1 2 19

Misc. Small Maps	<i>W.H.</i>
Cards	<i>W.H.</i>
Tracing	<i>W.H.</i>
France Map	<i>W.H.</i>
Scarborough Map	<i>W.H.</i>
Moody Map	<i>W.H.</i>
Geological Dept.	
Moody Flat Book	

Map No. 49 Sec. 22 Twp. 19 R. 9WWell No. 2 MurphyLauck & Moncrief CompanyCOMPLETED Contractor

C SL SE NW

 Ft. from N. Line330 Ft. from S. Line660 Ft. from E. Line Ft. from W. Line

SECTION PLAT

CHASE POOL

Location Rig up

Drilling and Remarks:

Cr 83209
5" @ 3209
1000 acid
Dep't. R 81513

45°/32

RECORD

Cased in., ft.Sand Gas Oil Total Depth 2219

PRODUCTION

1st 24 hrs. Nat. 1st 24 hrs. after shot Gas Cu. Ft.Dry Hole Abandoned

Date

JAN 28 1942 19 S. J. LEWIS Scout

Misc. Small Maps	<i>MAJ</i>
Cards	<i>MAJ</i>
Tracing	<i>MAJ</i>
France Map	<i>MAJ</i>
Scarborough Map	<i>MAJ</i>
Woody Map	<i>MAJ</i>
Geological Dept.	
Moody Flat Book	