

KANSAS

Rice

FORM 51 5M 10-41 PETROL


Section 22 Township 19 Range 9-W

Well No. #1 Nellie

Company Gulf

Chase Pool

NORTH

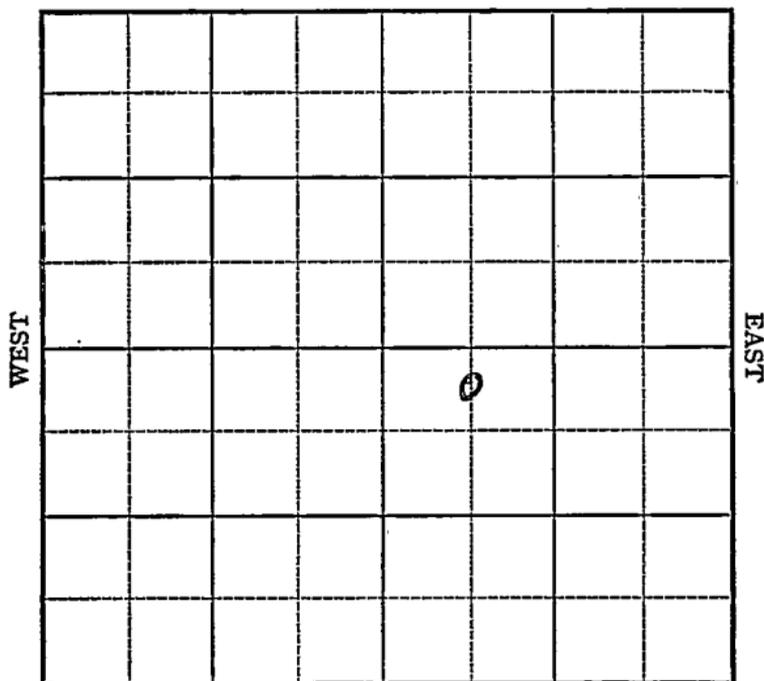

SOUTH

Sec. 22 Twp. 19 R. 9-W

Well No. #1 Nellie Farm

Gulf Company

(Chase)


330 Ft. from N. Line

_____ Ft. from S. Line

_____ Ft. from E. Line

660 Ft. from W. Line

Elev. 1701

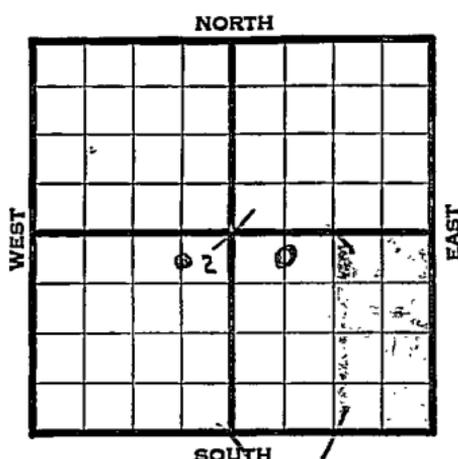

1942

REPORT

4/1	8" - 174' T.D. 180' WOC.
4/7	Top Kansas City 2870 Show oil 2929-30 & 2939-40 Dlg. 3174 (Gulf)
4/7	Expect to have the Arbuckle some time to-morrow, (April 8, 1942) (Letter - Orval)
4/8	Top Arbuckle 3227 Hard lime to 3232 Soft lime at 3233 T.D. 3233 To run casing tomorrow Did not core--Gulf say they do not know if there was a show oil (Tel)
Running-	level on Arbuckle with Lauck & Moncrief #2-Sledd C N/2 NE SW a 1040 bbl. Arbuckle producer (Peabody)
4/13	Cored 3233-36 recovered 6 inches hard tight dolomite drilled plugs and drilled to Total depth 3254' bailed 1 barrel oil in 6½ hours No water Still testing and will acidize (Gulf)

OVER

1942

4/13--Top Arbuckle 3227 Bottom rotary hole
3227' 5" cemented 3230
Drilled plug with trace of oil 3233'
Pay 3250-54 bailed 1 barrel oil in
6 hours. No water. Will drill deeper
(Letter Lewis)

4/15--Drilled deeper to T.D. 3258
Bailed 1 bbl. oil & 4 bbls. water in
5 hours Plug back with lead wool to
3255 $\frac{1}{2}$ ' Will acidize (Tel)

4/17--1000 acid
Pumped 6 gallons oil an hour show water
(Telegram--Lewis)

4/22 Shut down.

4/29 Shot 30 qts. 3239-51' 2000 acid.
Pump 6 $\frac{1}{2}$ oil per hour, no water.

5/6 " " " " "

5/8--Pumped 106 bbls. oil 8 hours
Official potential 321 bbls. (Telegram)

5/13 Arb. 3227'
5" - 3230'
T.D. 3258'
P.B. to 3255 $\frac{1}{2}$ '
Shot 30 qts. 3239-51'
3000 acid.
Potential 321 bbls., pump.
43.5 Gravity

COMPLETED

Rice

Map No. 49 Sec. 22 Twp. 19 R. 9W


Well No. 1 Nellie

Gulf Company

FIRST REPORT Contractor

C NL NW SE

SECTION PLAT

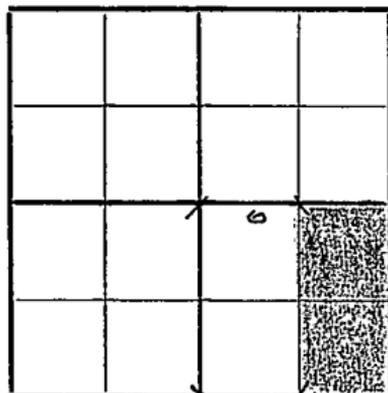

330 Ft. from N. Line

_____ Ft. from S. Line

_____ Ft. from E. Line

660 Ft. from W. Line

CHASE POOL

Location _____

Rig up _____

Drilling and Remarks:

8" - 174'

T.D. 180'

Waiting on
cement to set

RECORD

Cased _____ in., _____ ft.

Sand _____

Gas _____

Oil _____

Total Depth _____

PRODUCTION

1st 24 hrs. Nat. _____

1st 24 hrs. after shot _____

Gas _____ Cu. Ft.

Dry Hole _____

Abandoned _____

Date

APR 1 1942 19

S. J. LEWIS

Scout

Misc. Small Maps	<i>DM</i>
Cards	<i>DM</i>
Tracing	<i>DM</i>
France Map	<i>DM</i>
Scarborough Map	<i>DM</i>
Moody Map	<i>DM</i>
Geological Dept.	
Moody Plat Book	

Rice

KANSAS

Map No. 49 Sec. 22 Twp. 19 R. 9W

Well No. 1 Nellie

Gulf Company

COMPLETED Contractor

C NL NW SE

SECTION PLAT

330 Ft. from N. Line

_____ Ft. from S. Line

_____ Ft. from E. Line

660 Ft. from W. Line

		o	

CHASE POOL

Location _____

Rig up _____

Drilling and Remarks:

Cr 3227
5" 3238
PS 3255 1/2
389 to 3239-51
3000 acid
Pump 321 PLY
435 Gr

RECORD

Cased _____ in., _____ ft.

Sand _____

Gas _____

Oil _____

Total Depth 3258

PRODUCTION

1st 24 hrs. Nat. _____

1st 24 hrs. after shot _____

Gas _____ Cu. Ft.

Dry Hole _____

Abandoned _____

Date

MAY 13 1942 19

S. J. LEWIS Scout

Misc. Small Maps	<i>AY</i>
Cards	<i>AY</i>
Tracing	<i>AY</i>
France Map	<i>AY</i>
Scarborough Map	<i>AY</i>
Moody Map	<i>AY</i>
Geological Dept.	
Moody Plat Book	