

KANSAS


Rice

FORM 51 5M 10-41 PETROL

Section 22 Township 19 Range 9-W

Well No. #2 Nellie

Company Gulf

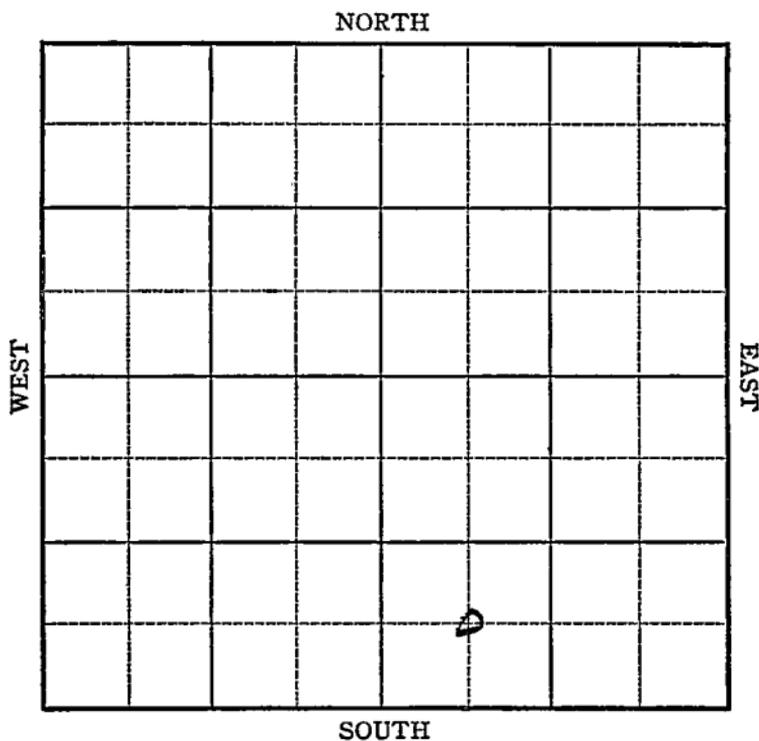

Sec. 22 Twp. 19 R. 9-W

Well No. #2 Nellie Farm

Gulf Company


Chase Pool

_____ Ft. from N. Line

660 Ft. from S. Line

_____ Ft. from E. Line

660 Ft. from W. Line

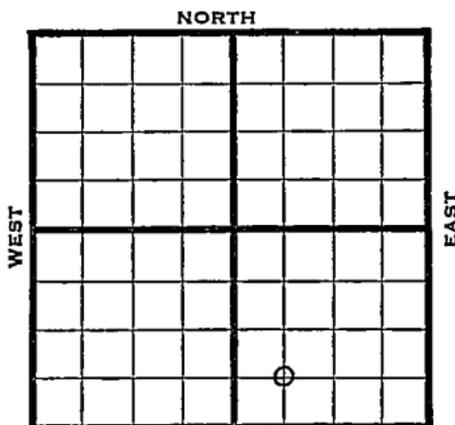

C SW SE *Elev. 1688*

1942

REPORT

12/22

Loc.

12/29

10" - 212 TD 1805 SD

1943

1/6

Lans 2853
Arb 3242
T. D. 3245
Stains SD.

1943

1/13

Arb 3240^{***} 1st. Corrected.
7" Casing set 3241
TD 3248' SD

1/20

1000 acid Pump 98½ oil
10 hrs SW.

1/27

" " "

2/3

Arb. 3240
7" casing set 3241'
T.D. 3243'
1000 gal acid
Pump 338 bbls oil plus 13 bbl water.
Gravity 44

COMPLETED

KANSAS

Rice

Map No. 29 Sec. 22 Twp. 19 R. 9WWell No. 2 Nellie

Gulf

Company

FIRST REPORT

Contractor

C S W S E

SECTION PLAT

		o	

_____ Ft. from N. Line

660 Ft. from S. Line

_____ Ft. from E. Line

660 Ft. from W. Line

CHASE POOL

Location XXX

Rig up _____

Drilling and Remarks:

RECORD

Cased _____ in., _____ ft.

Sand _____

Gas _____

Oil _____

Total Depth _____

PRODUCTION

1st 24 hrs. Nat. _____

1st 24 hrs. after shot _____

Gas: _____ Cu. Ft.

Dry Hole _____

Abandoned _____

Date

DEC 22 1942 19S. J. LEWIS Scout

Misc Small Maps *One*
Cards *Best*
Tracing *MS*
France Map *✓*
Scarborough Map *✓*
Moody Map *MS*
Geological Dept.
Moody Flat Book

KANSAS *49* Sec. **22** Twp. **19** R. **9W**

Well No. **2 Nellie**

Gulf Company

COMPLETED

Contractor

C SW SE

SECTION PLAT

_____ Ft. from N. Line

660 Ft. from S. Line

_____ Ft. from E. Line

660 Ft. from W. Line

		0	

CHASE POOL

Location _____

Rig up _____

Drilling and Remarks:

Cor 83240

7" @ 3241

1000 acid

Pump 338 oil + 13 Water

44 @ 8

RECORD

Cased _____ in., _____ ft.

Sand _____

Gas _____

Oil _____

Total Depth *3243*

PRODUCTION

1st 24 hrs. Nat. _____

1st 24 hrs. after shot _____

Gas _____ Cu. Ft.


Dry Hole _____

Abandoned _____

Date

FEB 3 1943 19

S. J. LEWIS Scout

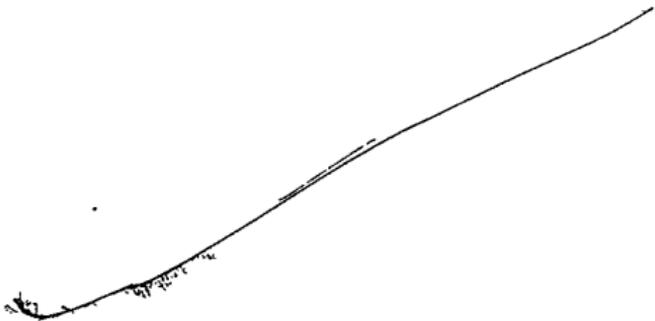

Misc Small Maps	<i>ma</i>
Cards.....	<i>Beats</i>
Tracing.....	<i>MS</i>
France Map.....	<i>MS</i>
Scarborough Map.....	<i>MS</i>
Moody Map.....	<i>MS</i>
Geological Dept.	
Moody Flat Book	