

KANSAS

Rice

FORM 51 5M 10-41 PETROL

Section 22 Township 19 Range 9-W

Well No. #1 Callis

Company Bishop Oil

Chase Pool NORTH

					1		
						0	

SOUTH


KANSAS Rice

Sec. 22 Twp. 19 R. 9-WWell No. #1 Callis Farm
Bishop Oil Company

(Chase Pool)

 Ft. from N. Line330 Ft. from S. Line990 Ft. from E. Line Ft. from W. Line

Elw. 1699

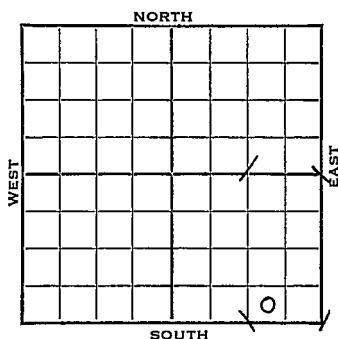

1942

REPORT

9/16

Surface hole.

9/23

8" @ 163 Drlg 2525

9/30

TD 3200 WOC. 5" - 3196

Lans. 2860 SO 2930-40 and 2953-60
& 3052-60 & 3081-92

Arb. 3196-3200

10/7

TD 3202 $\frac{1}{2}$ - 1000 acid

10/14

1000 acid pump 67 oil per hr.

10/21

32 qts 3207-30 TD 2000 acid pump 7
oil per hr 3 hrs.

11/4

" " " " "

11/11

" " " " "

11/18

Arb. 3196

5" @ 3196

T.D. 3202 $\frac{1}{2}$

32 qts. 3207-30

3000 Acid

Pump 475 bbls. Pot.


Gravity 44.7

COMPLETED

Map No. 49 Sec. 22 Twp. 19 R. 9WWell No. 1 CallisBishop Oil CompanyFIRST REPORT Contractor

SW SE SE

SECTION PLAT

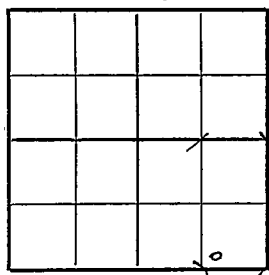 Ft. from N. Line330 Ft. from S. Line990 Ft. from E. Line Ft. from W. Line

CHASE POOL

Location Rig up

Drilling and Remarks:

Surface Hole

RECORD

Cased in., ft.Sand Gas Oil Total Depth

PRODUCTION

1st 24 hrs. Nat. 1st 24 hrs. after shot Gas Cu. Ft.Dry Hole Abandoned

Date

SEP 16 1942 19 S. J. LEWIS Scout

KANSAS

Rice

Map No. 119 Sec. 22 Twp. 19 R. 9WWell No. 1 Call isBishop Oil CompanyCOMPLETED Contractor

SW SE SE

SECTION PLAT

 Ft. from N. Line330 Ft. from S. Line990 Ft. from E. Line Ft. from W. Line

			6

CHASE POOL

Location Rig up

Drilling and Remarks:

*Ar 83196 **5" @ 3196**32 g to 3207-30**3000 acid**Pump 475 BX**442 44*

RECORD

Cased in., ft.Sand Gas Oil Total Depth 3202 1/2

PRODUCTION

1st 24 hrs. Nat. 1st 24 hrs. after shot Gas Cu. Ft.Dry Hole Abandoned

Date

NOV 18 1942 19 S. J. LEWIS Scout