

KANSAS

FORM 51 5M 10-41 PETROL


Rice

Section 22 Township 19 Range 9-W

Well No. #3 Murphy "A"

Company Lauck & Moncrief

Chase Pool

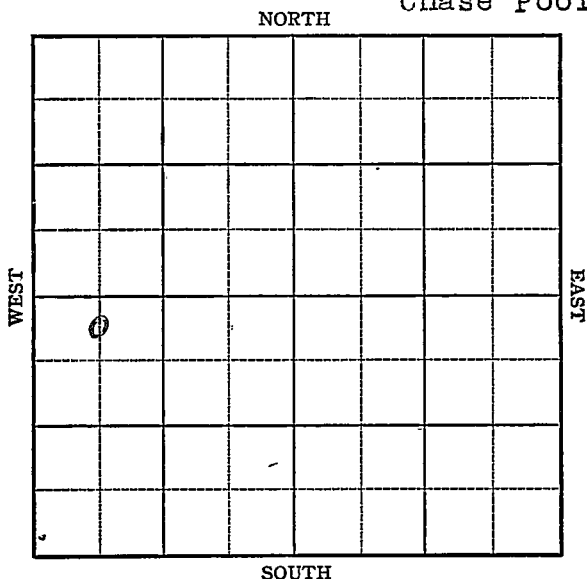

Rice

KANSASMap No. 49 Sec. 22 Twp. 19 R. 9WWell No. 3 Murphy "A"Lauck & Moncrief Company**FIRST REPORT** Contractor

C NL NW SW

SECTION PLAT

0			

330 Ft. from N. Line Ft. from S. Line Ft. from E. Line660 Ft. from W. Line

CHASE POOL

Location Rig up

Drilling and Remarks:

Derrick

RECORD

Cased in., ft.Sand Gas Oil Total Depth

PRODUCTION

1st 24 hrs. Nat. 1st 24 hrs. after shot Gas Cu. Ft.Dry Hole Abandoned

Date

APR 15 1942 19

S. J. LEWIS Scout

KANSAS

Map No. 49 Sec. Rice 22 Twp. 19 R. 9WWell No. 3 Murphy "A"Lauck & Moncrief CompanyCOMPLETE Contractor

C NL NW SW

330 Ft. from N. Line Ft. from S. Line Ft. from E. Line660 Ft. from W. Line

SECTION PLAT

0			

CHASE POOL

Location Rig up

Drilling and Remarks:

*Cur 3238**5" @ 3238 Lams 2563**PB 3206**90 shot to 2933-50**3000 acid**Pump. 46 P. X.**435 yd*

RECORD

Cased in., ft.Sand Gas Oil Total Depth 3257

PRODUCTION

1st 24 hrs. Nat. 1st 24 hrs. after shot Gas Cu. Ft.Dry Hole Abandoned

Date

MAY 13 1942 19

S. I. LEWIS Scout