

KANSAS


FORM 51 5M BRIX

Rice

Section 22 Township 19 Range 9W

Well No. #5 Murphy "A"

Company Lauck & Moncrief

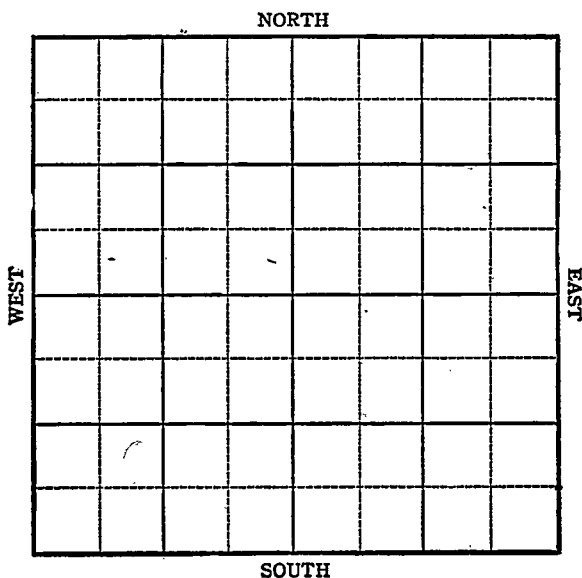

Sec. 22 Twp. 19 R. 9W

Well No. #5 Murphy "A" Farm

Lauck & Moncrief Company

Chase

NORTH

 Ft. from N. Line


990 Ft. from S. Line

 Ft. from E. Line

990 Ft. from W. Line

WEST

EAST

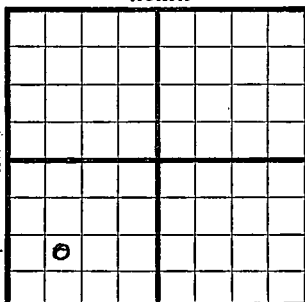

SOUTH

NE SW SW

Shaw 1688

1944

R E P O R T

8/16	Rot.
8/23	10" @ 117 Drlg. 1145
8/30	Lans 2868 Drlg. 2967
9/8	Arb. 323-25 TD SO 5" @ 3214 RUST
9-13	Arb 3212 5" @ 3214 Pump 80 Pot 42.3 Gr. TD 3234

COMPLETED

KANSAS

Pool Name ChaseMap No. 49 Sec. 22 Twp. 19 R. 9WWell No. 5 Murphy "A"Lauck & Moncrief

Company

FIRST REPORT

Contractor

NE SW SW

SECTION PLAT

 Ft. from N. Line990 Ft. from S. Line Ft. from E. Line990 Ft. from W. LineRice CountyLocation Rig up

Drilling and Remarks:

Rotary

RECORD

Cased in., ft.Sand Gas Oil Total Depth

PRODUCTION

1st 24 hrs. Nat. 1st 24 hrs. after shot Gas Cu. Ft.Dry Hole Abandoned

Date

AUG 16 194419S. J. LEWISScout

Pool Name ChaseMap No. 49 Sec. 22 Twp. 19 R. 9WWell No. 5 Murphy "A"Tanck & Moncrief


Company

COMPLETED

Contractor

NE SW SW

SECTION PLAT

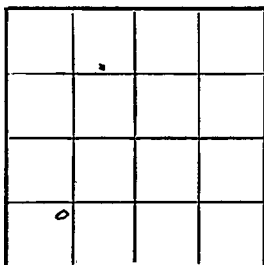 Ft. from N. Line990 Ft. from S. Line Ft. from E. Line990 Ft. from W. LineRice CountyLocation Rig up

Drilling and Remarks:

Ar 83212.3"-C 8214Pump 50 P.D.42 3/4**RECORD**Cased in., ft.Sand Gas Oil Total Depth 3234**PRODUCTION**1st 24 hrs. Nat. 1st 24 hrs. after shot Gas Cu. Ft.Dry Hole Abandoned

Date

SEP 13 1944 19S. J. LEWIS

Scout