




Sec. 22 Twp. 19 R. 9-W

Well No. #1 Reece Farm

Bishop Oil Company

(Chase)

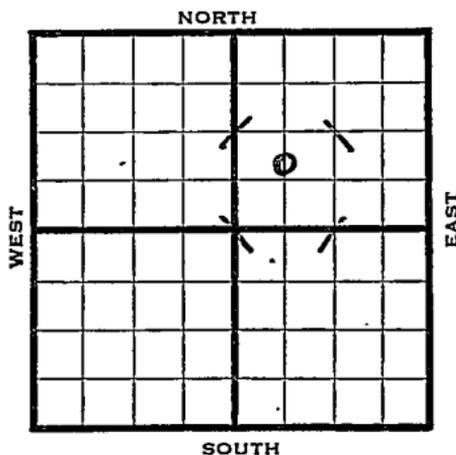

\_\_\_\_\_ Ft. from N. Line

760 Ft. from S. Line

\_\_\_\_\_ Ft. from E. Line

660 Ft. from W. Line

*Elev. 1706*

1942		REPORT			
7/8	10" - 211' Drlg. 1134'				
7/15	Topeka 2441'	Drlg. 2865'			
7/22	Lans. 2876 TD 3251	Sooy 3186 RUST	Arb. 3237'		
7/29	PB 3165 - 59 shots 2939-48 Swb 3 fluid P.H. 50% water.				
8/5	4000 acid	Pump 8 Fluid per hr.			
8/12	" "	" "			
8/19	" "	" "			
8/27	" "	" "			
9/2	" "	" "			
9/9	Lans. 2876 Arb. 3237 5" - 3241 T.D. 3251 PB 3174 59 shots 2939-48 4000 acid Pump 166 Pot. Gravity 45.				

**COMPLETED**

Rice

KANSAS

Map No. 49 Sec. 22 Twp. 19 R. 9WWell No. 1 Reece

Bishop Oil

Company

FIRST REPORT

Contractor


C S W N E

SECTION PLAT

\_\_\_\_\_ Ft. from N. Line

760 Ft. from S. Line

\_\_\_\_\_ Ft. from E. Line

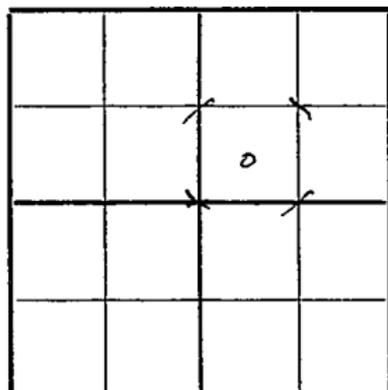660 Ft. from W. Line

CHASE POOL

Location \_\_\_\_\_

Rig up \_\_\_\_\_

Drilling and Remarks:

10" - 211'

Drlg. 1134'

RECORD

Cased \_\_\_\_\_ in., \_\_\_\_\_ ft.

Sand \_\_\_\_\_

Gas \_\_\_\_\_

Oil \_\_\_\_\_

Total Depth \_\_\_\_\_

PRODUCTION

1st 24 hrs. Nat. \_\_\_\_\_

1st 24 hrs. after shot \_\_\_\_\_

Gas \_\_\_\_\_ Cu. Ft.

Dry Hole  \_\_\_\_\_

Abandoned \_\_\_\_\_

Date

JUL 8 1942S. J. LEWIS Scout

Map No. 49 Sec. 22 Twp. 19 R. 9WWell No. 1 ReeceBishop Oil Company**COMPLETED** Contractor

C S W N E

SECTION PLAT

         Ft. from N. Line760 Ft. from S. Line         Ft. from E. Line660 Ft. from W. Line


CHASE POOL

Location         Rig up         

Drilling and Remarks:

*Lians 2876**Cr 43237**5" @ 3241**PB 3175**59 shot to 2939-48**4000 acid**Pump 166 P/B*

Date

*45<sup>e</sup>/46*

RECORD

Cased          in.,          ft.Sand         Gas         Oil         Total Depth 3251

PRODUCTION

1st 24 hrs. Nat.         1st 24 hrs. after shot         Gas          Cu. Ft.Dry Hole         Abandoned         

SEP 9 1942 19

S. J. LEWIS Scout