


Section 22 Township 19 Range 9-W

Well No. 1 Sledd Farm Corp.

Company Lauck & Moncrief et al

NORTH Campbell Pool

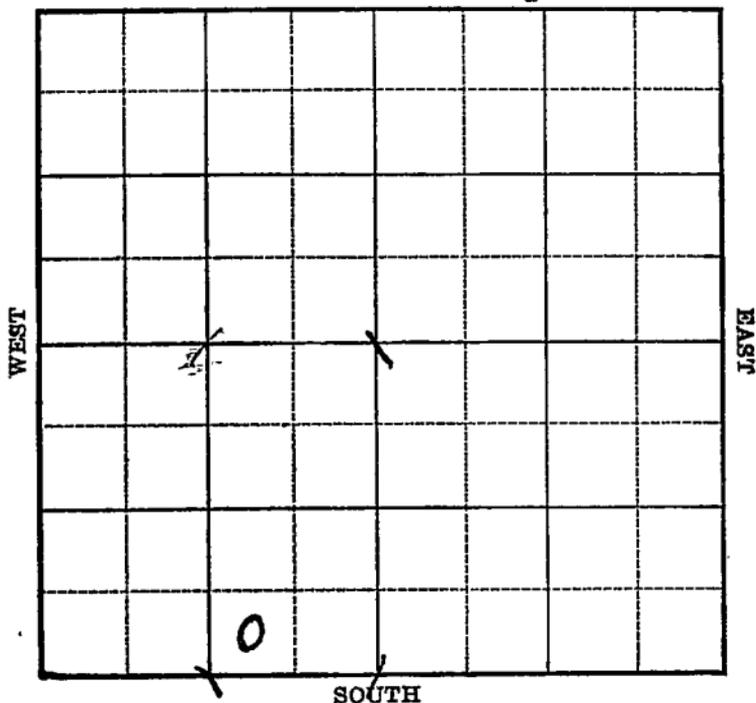


Sec. 22 Twp. 19 R. 9-WWell No. #1 Sleds Farm Corp. FarmLauck & Moncrief et al Company

(Campbell)

_____ Ft. from N. Line

330 Ft. from S. Line990 Ft. from E. Line

_____ Ft. from W. Line

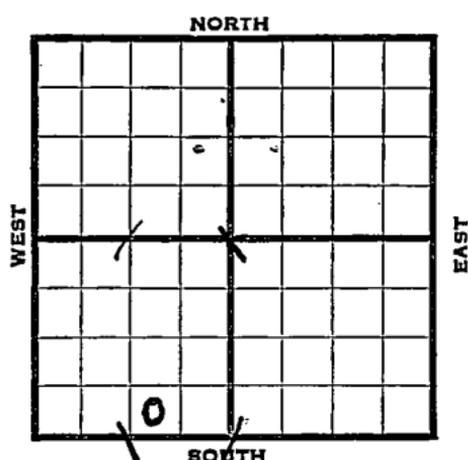

Elev. 1681'

1939	REPORT
2//15	R.U.R.
2/23	10" - 120' Drlg. 487'
3/3	Drlg. 2690'
3/7	Top Lansing 2854 Top Arbuckle 3205 Cored 3210-15 Recovered 3 feet Small show oil TD 3215 Will run but not cement casing (Tel)
3/8	Cemented 5" Rust (Tel)
3/10	Drilled plugs & deepened to TD 3228 Acidized 1000 gallons Cleaned out Filled up 50 to 75' oil in 30 minutes Let set over night Had 400' oil in hole No water (Tel)
3/13	TD 3228: Swab 2 bbls. per hour off bottom Deepened to TD 3236 Swab 2½ bbls. per hour 2000 gallons acid Swab 29 bbls. in 5 hrs. net Last hour made 7½ bbls. (Tel)
3/18	Pump 101 bbls. oil & 8 bbls. water in 8 hrs. Potential 302 bbls. (Tel)

OVER

1939

3/22

5" - 3205'

Arb. 3205'

T. D. 3236'

3000 acid (Total)

Pump 101 oil & 8 water in 8 hrs.

Potential 302 bbls.

COMPLETED

Rice

Map No. 49 Sec. 22 Twp. 19 R. 9WWell No. 1 Sleds Farm Corp.Lauck & Moncrief etal Company

Contractor

FIRST REPORT


SW SE SW

_____ Ft. from N. Line

330 Ft. from S. Line990 Ft. from E. Line

_____ Ft. from W. Line

SECTION PLAT

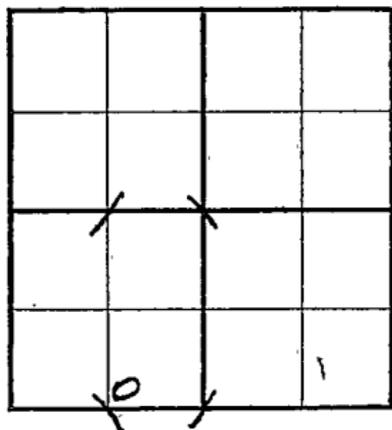

CAMPBELL POOL

Location _____

Rig up _____

Drilling and Remarks:

RUR

RECORD

Cased _____ in., _____ ft.

Sand _____

Gas _____

Oil _____

Total Depth _____

PRODUCTION

1st 24 hrs. Nat. _____

1st 24 hrs. after shot _____

Gas _____ Cu. Ft.

Dry Hole _____

Abandoned _____

Date

FEB 15 1939 19

H. D. Hatfield Scout

Misc Small Maps
Cards
Tracing
France Map
Scarborough Map
Moody Map
Geological Dept.
Moody Flat Book

Ray
Ray
Ray
Ray

Rice

KANSAS

Map No. 49 Sec. 22 Twp. 19 R. 9W

Well No. 1 Sledd Farm Corp.

Lauck & Moncrief etal Company

Contractor

COMPLETED

SECTION PLAT

SW SE SW

_____ Ft. from N. Line

330 Ft. from S. Line

990 Ft. from E. Line

_____ Ft. from W. Line

CAMPBELL POOL

	0		

Location _____

Rig up _____

Drilling and Remarks:

3000 Acid (TOTAL)

P-101 oil 48 wt/8

Pot 302

RECORD

Cased 5 in., 3205 ft.

Sand Atb 3205

Gas _____

Oil _____

Total Depth 3236

PRODUCTION

1st 24 hrs. Nat. _____

1st 24 hrs. after shot _____

Gas _____ Cu. Ft.

Dry Hole _____

Abandoned _____

Date

MAR 22 1939 19 H. D. Hatfield Scout

Misc. Small Maps *Ray*
Cards *Ray*
Tracing *grr*
France Map *Ray*
Scarborough Map *Ray*
Moody Map *Ray*
Geological Dept. —
Moody Plat Book