


Section 22 Township 19 Range 2W

Well No. #2 Kielman

Company John Darrah et al

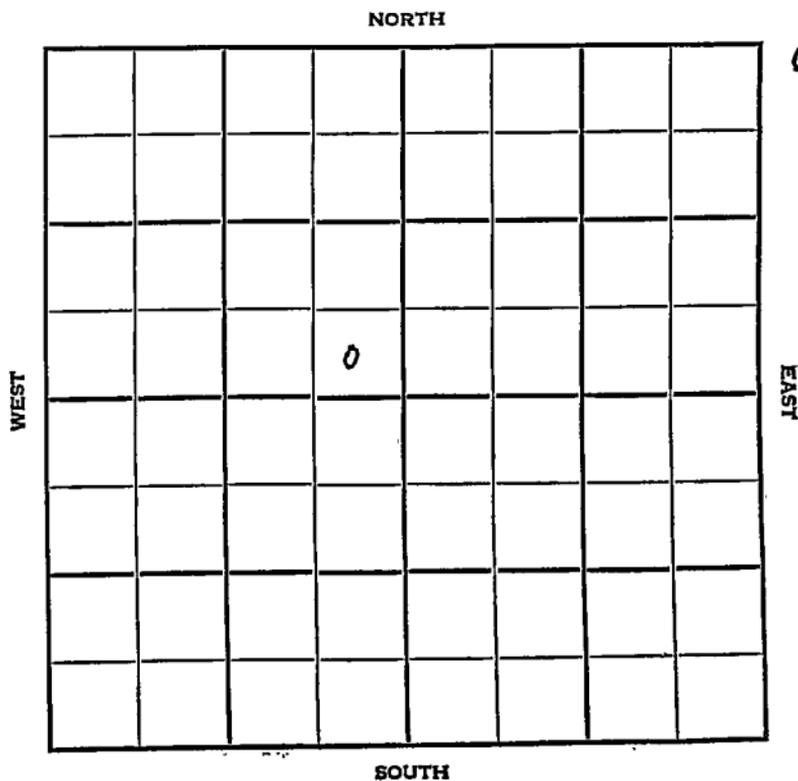

McPherson

KANSAS

SEC.	TWP.	R.
22	19	2W

WELL NO.

#2 Kielman

FARM

COMPANY

John Darrah et al

CONTRACTOR

Lively Pool

NORTH

_____ Ft. from N. Line


330

_____ Ft. from S. Line

330

_____ Ft. from E. Line

_____ Ft. from W. Line

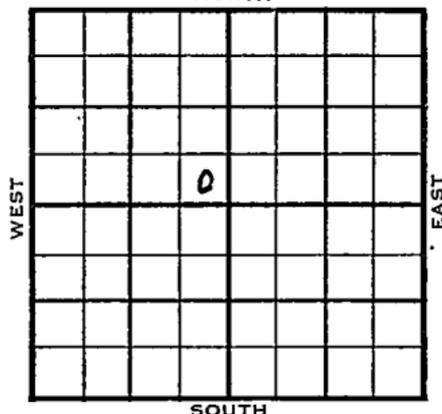

SE SE NW

1954	ELEVATION 1551'	REPORT
------	--------------------	--------

9/1 Location

11/3 Spud 9-9-54

Oil Well

TD 2954'

8" @ 170'

Lans 2321', ReMiss 2926', Miss Chat 2935'

TD 2949'

5" @ 2945'

CO to 2949' FU 650' fluid 60% oil 1 1/4 hr. 250 M-A DD 2954 S/ 3/4 bo 3/4 bw sd-frac S/ 1 1/2 bo 1 1/2 bwph 8 hr.

Comp 22 bopd. 30% Wtr.

COMPLETED

