
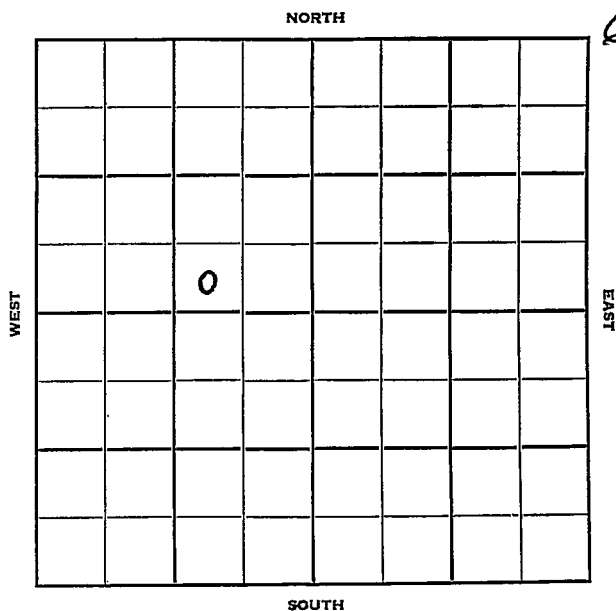


Section 22 Township 19 Range 2 WWell No. # 1 Fred DielmanCompany John Darrah et al

Sec. 22 Twp. 19 R. 2WWell No. #1 Fred DieIman FarmJohn Darrah et al. CompanyBarnett Drlg. ContractorLively Pool Ft. from N. Line330 Ft. from S. Line990 Ft. from E. Line Ft. from W. Line

SW SE NW

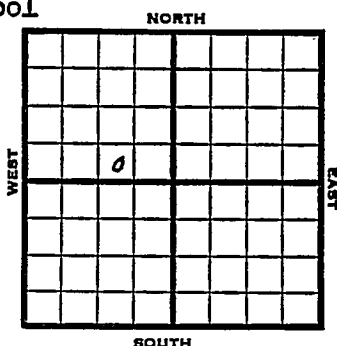

1953 Elev. 1551' REPORT

6/24 Spud 6-20-53
8" @ 165'

Drlg 540'

7/1 Miss 2946

Drlg 2942'

7/8 RTD 2961

5" @ 2961'

7/22 NR

7/29 CO 2961

S/W & SO

PB 2950

9/23 Spud 6-20-53

Oil Well

TD 2961'

8" @ 165'

KC 2333, Miss 2942,

TD 2961'

5" @ 2950'

DD 2963'

S/ wt r & SO PB 2950 CO to 2955


12/ 2950-55 1000 A FU 600' oil 12 hr

S/ 10 bo 80 bw P/ 23 bopd 30% wtr.

Comp. 20 bopd.

COMPLETED

County McPherson State Kansas
 Sec. 22 (Blk. Twp.) 19 (Sur. Rge.) 2 W Map No. _____
 Operator John Darrah et al.
 Well No. 1 Farm Fred Dielman
 Elev. _____ Location SW SE NW

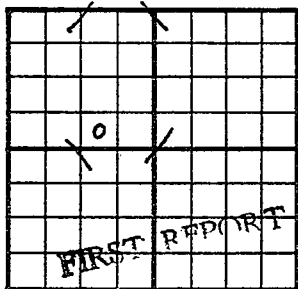

330 Ft. From S Line NW
990 Ft. From E Line Quarter

1st. Report JUN 24 1953

Completion _____

Remarks _____

Barnett Drlg. - Contr.


Spudding Date 6-20-53

Drlg. Data _____

Lively Pool

8" @ 165 drlg. 540

J. G. McGEHEE

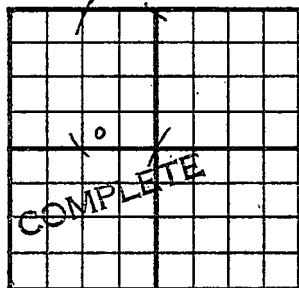County McPherson State KansasSec. 22 (Blk.) 19 (Sur.) 2W Map No.Operator John Darrah et al.Well No. 1 Farm Fred DielmanElev. 1551 Location SW SE NW330 Ft. From S Line NW990 Ft. From E Line Quarter1st. ReportCompletion SEP 23 1953Remarks Lively PoolBarnett Drlg. - Contr.Spudding Date 6-20-53Drlg. Data Oil well TD 29618" @ 165 KC 2333 Miss. 2942TD 2961 5" @ 2950 DD 2963 S/ wtr. & SOPB 2950 CO to 2955 12/ 2950-551000 A FU 600' oil 12 hr. S/ 10 bo80 bw P/ 23 bopd 30% wtr.Comp. 20 bopd

J. G. McGEHEE