


Section 22 Township 19 Range 2W

Well No. 2 Anderson "A"

Company National Assoc.

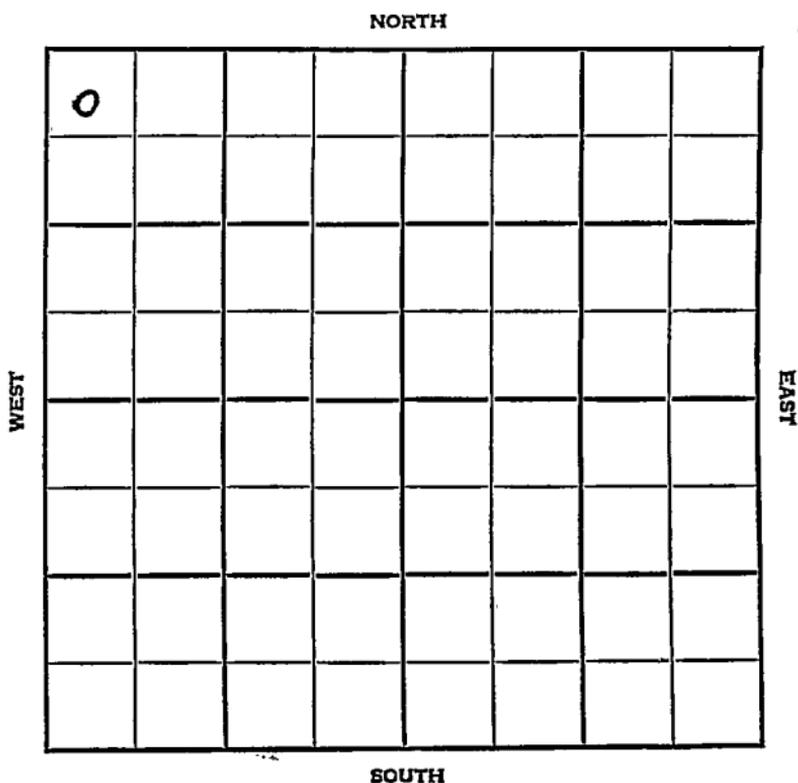

McPherson KANSAS

SEC.	TWP.	R.
22	19	2W

WELL NO. 2 <sup>A</sup>nderson "A" FARM

COMPANY National Assoc.

CONTRACTOR Lincoln Drlg.


Lively Pool

330 Ft. from N. Line

Ft. from S. Line

Ft. from E. Line

330 Ft. from W. Line

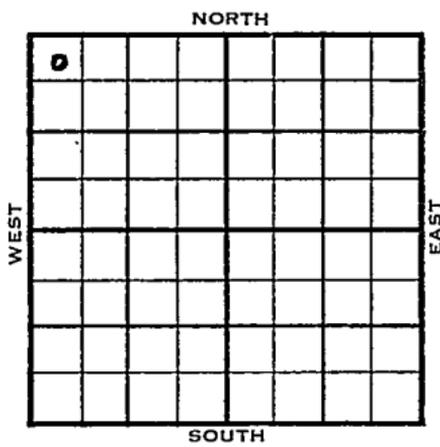

NW NW NW

1955	ELEVATION	REPORT
	<del>1540</del> 1550	

1/26 RUR  
~~4/6 Spud 2-3-55, Oil Well, TD 2968  
 8" @ 162, KC 2319, Miss 2949,  
 TD 2968, 5" @ 2958, CO to 2968  
 B/9 GOPH 3 hr. frac S/3 BO  
 2 BWPH 20 hr.  
 Comp. 15 BOPD 60 BW~~

4/6 Spud 1-24-55, Oil well; TD 2966, 8" @ 154, KC 2318, Miss 2950, TD 2966, 5" @ 2959 CO to 2966, S/1/2 BOPH 8 hr frac S/6 BO 1 BWPH 12 hr. Comp 20 BOPD 35 BW

**COMPLETED.**

County McPherson State Kansas

Sec. 22 (Blk. 19 (Sur. 2W (Twp. 19 (Rge. 2W Map No.

Operator National Assoc.

Well No. 2 Farm Anderson "A"

Elev. \_\_\_\_\_ Location NW NW NW

0							

330 Ft. From N Line NW

330 Ft. From W Line Quarter

1st. Report JAN 26 1955

Completion \_\_\_\_\_

Remarks \_\_\_\_\_

Lincoln Drlg. - Contr.

Spudding Date \_\_\_\_\_

Drlg. Data Lively Pool

R U R

FABEN GILSTRAP

County McPherson State Kansas

Sec. 22 (Blk.) 19 (Sur.) 2W Map No.

Operator National Assoc.

Well No. 2 Farm Anderson "A"

Elev. 1550 Location NW NW NW

0							

330 Ft. From. N Line NW

330 Ft. From W Line Quarter

Ist. Report

Completion APR 6 1955

Remarks Lively Pool

Lincoln Drlg. - Contr.

Spudding Date 1-24-55

Drlg. Data Oil well TD 2966

8" @ 154 KC 2318 Miss. 2950

TD 2966 5" @ 2959 CO to 2966

S/ 1/2 boph 8 hr. frac S/-6 bo 1 bwph

12 hr. Comp. 20 bopd. 35 bw

FABEN GILSTRAP