

M^cPherson
FORM 252A-5M-6-30-PETROL

Map No. KANSAS Sec. 22 Twp. 19 R. 2^w

Well No. 1- Dillman Farm


Twin Dry-Phillips Company
and Shell NORTH

660 Ft. from N. Line

_____ Ft. from S. Line

660 Ft. from E. Line

_____ Ft. from W. Line

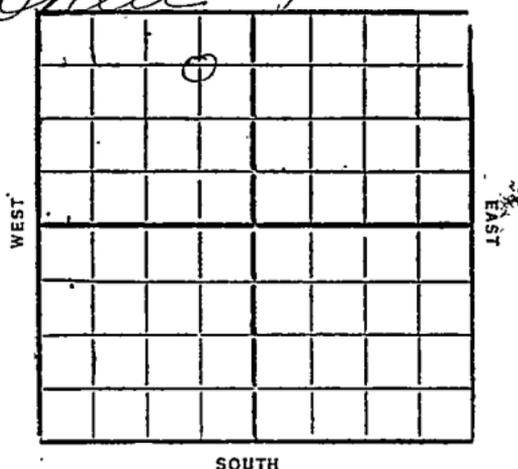

1931


Date	REPORT
1/28	Bldg rig
2/4	Rig up
2/11	Spud
2/18	Dry 600'
2/25	" 1380'
3/4	" 2000'
3/11	" 2200'
3/18	" 2630'
3/25	Top Chat 2948 show oil & gas HFV 2980-90 Dry 3015'
4/1	76"- 3152 Base line 3153 Dry 3195'
4/8	Viola 3426-34 TD. 3434' HFV Dry & abandon

Map No. **KANSAS** Sec. 22 Twp. 19 R. 2W

Well No. 43 1 Dieleman

Twin Drilling - Phillips & Shelton Company
Contractor

SECTION PLAT

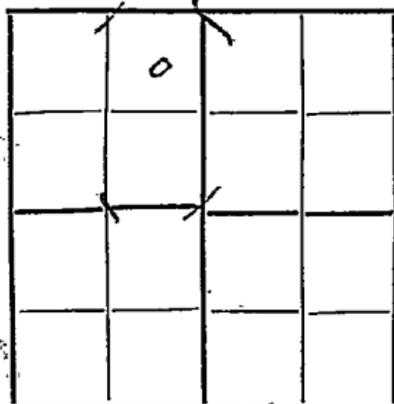

660 Ft. from N. Line

..... Ft. from S. Line

660 Ft. from E. Line

..... Ft. from W. Line

FIRST REPORTS

Location.....

Rig up.....

Drilling and Remarks:

Building rig
SJ

RECORD

Cased..... in., ft.

Sand.....

Gas.....

Oil.....

Total Depth.....

PRODUCTION

1st 24 hrs. Nat.....

1st 24 hrs. after shot.....

Gas..... Cu. Ft.

Dry Hole.....

Abandoned.....

Date

JAN 28 1931

S. J. LEWIS Scout

McPherson

43 KANSAS

Map No. _____ Sec. *22* Twp. *19* R. *2 W*

Well No. *1* *Dielman*

John Drey-Phillips & Shell Company:

Contractor

COMPLETE

660 Ft. from N. Line

_____ Ft. from S. Line

660 Ft. from E. Line

_____ Ft. from W. Line

ABANDONED

SECTION PLAT

.	o		

Location _____

Rig up _____

Drilling and Remarks:

Uicla 3426-34

HFW

D+a 3434

RECORD

Cased _____ in., _____ ft.

Sand _____

Gas _____

Oil _____

Total Depth *3434*

PRODUCTION

1st 24 hrs. Nat. _____

1st 24 hrs. after shot _____

Gas _____ Cu. Ft.

Dry Hole *✓*

Abandoned *✓*

Date

APR 8 1931

192 CHAS. L. SHERWOOD

Scout