


Section 22 Township 19 Range 2W

Well No. 2 Scott

Company National Assoc. Petr.

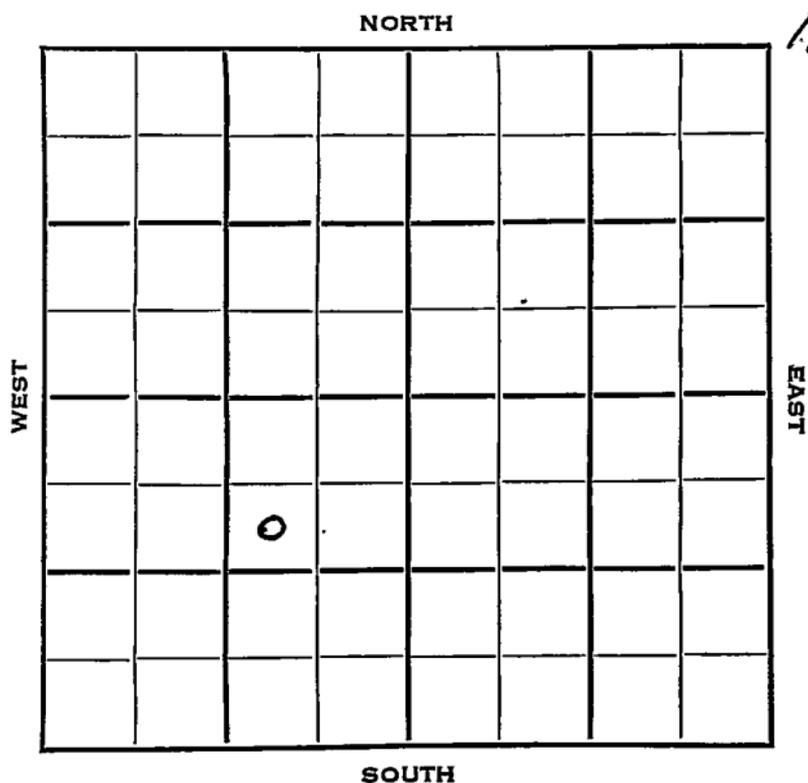

McPherson KANSAS

SEC.	TWP.	R.
22	19	2W ✓

WELL NO. 2 Scott FARM

COMPANY National Assoc. Petr.

CONTRACTOR Lincoln Drlg.


Lively Pool

990 Ft. from N. Line

Ft. from S. Line

990 Ft. from E. Line

Ft. from W. Line

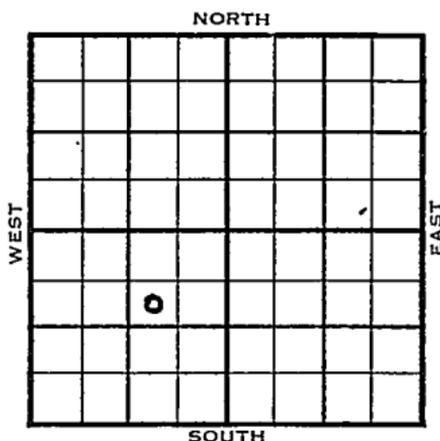

SW NE SW

	ELEVATION	REPORT
1954	1554'	

1/13 MIR

1/20 8" @ 188 w/135 KC 2336'
Drlg. 2750'

1/27 Miss 2942'
RTD @ 2947'
5" @ 2946'

2/3 NR

3/17 NR

3/24 Spud 1-12-54 Oil well TD 2956
8" @ 188 KC 2336 Miss 2942
TD 2947 5" @ 2946 DD 2949
12 GOPH DD 2951 B/1/2 BOPH DD 2954
S/3/4 BOPH DD 2956 S/3/4 BOPH 5%
wtr. PB 2954 st-frac S/8 BOPH 2 BW
8 hr.
Comp. 95 BOPD 78% wtr.

COMPLETED

County McPherson State Kansas

Sec. 22 (Blk. Twp.) 19 (Sur. Rge.) 2W Map No.

Operator National Assoc. Pet.

Well No. 2 Farm Scott

Elev. Location SW NE SW

FIRST REPORT							

990 Ft. From N Line SW

990 Ft. From E Line Quarter

1st. Report JAN 13 1954

Completion _____

Remarks _____

Lincoln Drlg. - Contr.

Spudding Date _____

Drlg. Data Lively Pool

M I R

J. G. MCGEHEE

