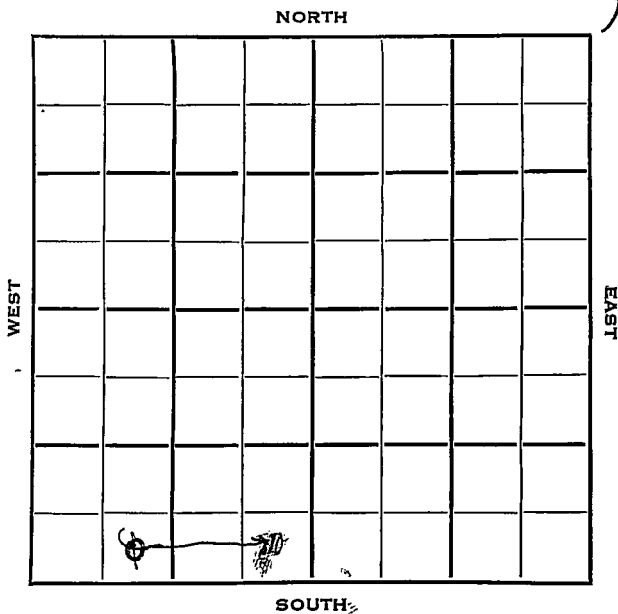


Section 22 Township 19 Range 2 WWell No. # 1 ScottCompany National Assoc. Pet.

McPherson KANSAS

SEC.	TWP.	R.
22	19	2W ✓

WELL NO.

1 Scott

FARM

COMPANY

National Assoc. Petr.


CONTRACTOR

Natl. Assoc.

_____ Ft. from N. Line

330 _____ Ft. from S. Line

330 _____ Ft. from E. Line

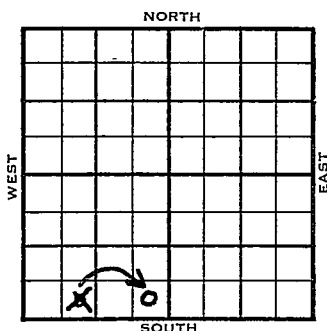~~990~~ _____ Ft. from W. LineSE ^{SE} SW

1953

ELEVATION

1553'

REPORT

11/24

Spud 11-20-53

8" @ 150'

KC 2326'

Drlg. 2700'

12/22

Spud 11-20-53

Oil Well

TD 2949'

8" @ 150'

KC 2326', Miss 2939'

TD 2945'

5" @ 2945'

DD 2949


S/1/2 boph 16 hrs., 500A

S/7 boph

Comp. 184 bopd

COMPLETED

County McPherson State Kansas
 Sec. 22 (Blk.) 19 (Sur.) 2W Map No.
 Operator National Assoc. Pet.
 Well No. 1 Farm Scott
 Elev. _____ Location SE SW SW

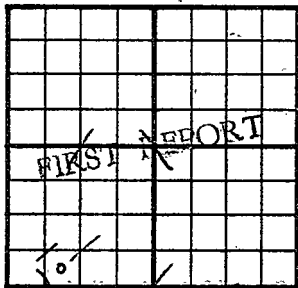

330 Ft. From S Line SW
990 Ft. From W Line Quarter
 1st. Report NOV 24 1953
 Completion _____
 Remarks Natl. Assoc. - Contr.
 Spudding Date 11-20-53

Drlg. Data

8" @ 150 KC 2326 drlg. 2700

J. G. McGENEE

Kansas

Map No. _____ Sec. 22 Twp. 19 R. 2WWell No. 1 Scott

National Assoc. _____ Company

CORRECTION Contractor

SE SE SW

SECTION PLAT

_____ Ft. from N. Line

330 Ft. from S. Line330 Ft. from E. Line

_____ Ft. from W. Line

McPherson County

Location _____

Rig up _____

Drilling and Remarks:

Reported

SE SW SW

RECORD

Cased _____ in., _____ ft.

Sand _____

Gas _____

Oil _____

Total Depth _____

PRODUCTION

1st 24 hrs. Nat. _____

1st 24 hrs. after shot _____

Gas _____ Cu. Ft.

Dry Hole _____

Abandoned _____


Date

DEC 2 1953 19

J. G. McGEHEE

Scout

County McPherson State Kansas
 Sec. 22 (Blk. 19) (Sur. 2W) Map No. 2W
 Operator National Assoc. Pet.
 Well No. 1 Farm Scott
 Elev. 1553 Location SE SE SW

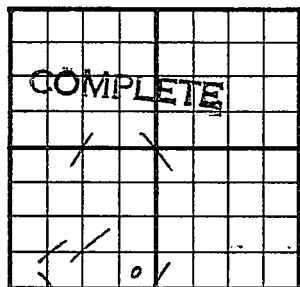

330 Ft. From S Line SW

330 Ft. From E Line Quarter

1st. Report

Completion DEC 22 1953

Remarks

Natl. Assoc. - Contr.

Spudding Date 11-20-53

Drilg. Data Oil well TD 2949

8" @ 150 KC 2326 Miss. 2939 TD 2945

5" @ 2945 DD 2949 S/ $\frac{1}{2}$ boph 16 hr.

500 A S/ 7 boph Comp. 184 bopd

J. G. McGEHEE