

Section 22 Township 19 Range 2 WWell No. # 1 ThompsonCompany Geo. Hess

NORTH

WEST

EAST

SOUTH

0

15

McPherson

KANSAS

SEC.	TWP.	R.
22	19	2W ✓

WELL NO.

1 Thompson "A"

FARM

COMPANY

Geo. Hess

CONTRACTOR

Mallard Drlg.

Lively Pool


_____ Ft. from N. Line

330 _____ Ft. from S. Line

_____ Ft. from E. Line

330 _____ Ft. from W. Line

SW SW SE

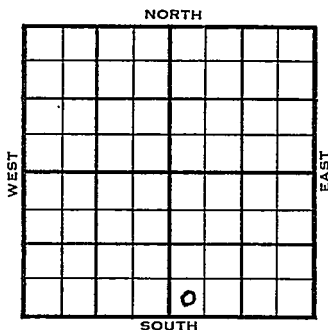

	ELEVATION	REPORT
1953	1553'	

10/21	Spud 10-15-53 8" @ 155' Drlg. 2070'
10/28	KC 2325', Miss 2937' RTD 2947' 5" @ 2944'
11/4	CO 2947' A-frac F 3 boph
11/11	POP
11/18	"
12/30	Spud 10-15-53 Oil well TD 2947' 8" @ 155' KC 2325' Miss 2937' TD 2947' 5" @ 2944' CO to 2947' A-frac. F/3 BOPH P/50 BOPD P/28 BOPD Comp. 40 BOPD

COMPLETED

County **McPherson** State **Kansas**

Sec. 22 (Blk. Twp.) 19 (Sur. Rge.) 2 W Map No.

Operator Geo. Hess

Well No. 1 Farm Thompson

Elev.	Location	SW	SW	SE
-------	----------	----	----	----

FIRST REPORT

330 Ft. From S Line SE

330 Ft. From ~~TF~~ Line Quarter

1st. Report OCT 21 1953

Completion

Remarks

Mallard Brig. - Contr.

Spudding Date **10-15-53**

Drlg. Data Lively Pool

8th @ 155 drlg. 2070

County McPherson State Kansas

Sec. 22 (Blk. Twp.) 19 (Sur. Rge.) 2W Map No.

Operator Geo. Hess

Well No. 1 Farm Thompson "A"

Elev.	1553	Location	SW SW SE
-------	------	----------	----------

COMPLETE

330 Ft. From S Line SE

330 Ft. From W Line Quarter

1st. Report _____ 1958

Completion

Remarks Lively Pool

Mallard Drlg. - Contr.

Spudding Date 10-15-53

Drilg. Data Oil well TD 2947

8" @ 155 KC 2325 Miss. 2937

TD 2947 5" @ 2944 CO to 2947

A-frac F/ 3 boph P/ 50 bopd

P/ 28 bopd Comp. 40 bopd

J. G. McGEHEE