


Section 21 ²² Township 19 Range 2W

Well No. #1 Wedel

Company Geo. Hess et al

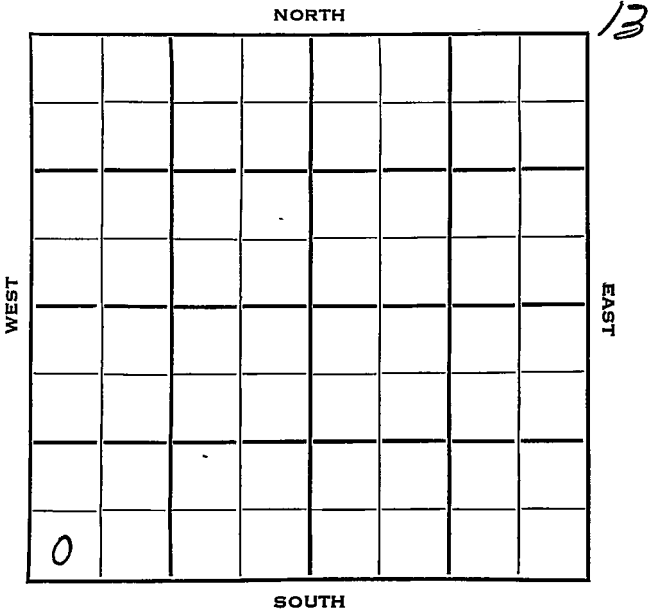

McPherson

Sec. 21 22 Twp. 19 R. 2W

Well No. #1 Wedel Farm

Geo. Hess, et al Company

Mallard Drlg. Contractor

Lively


Ft. from N. Line

330 Ft. from S. Line

Ft. from E. Line

330 Ft. from W. Line

SW SW SW

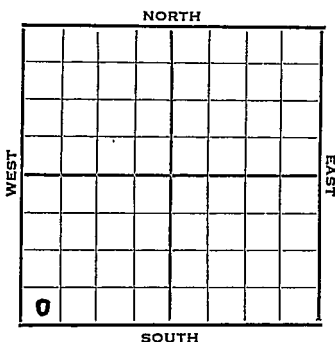

1953 Elev. 1548' REPORT

7/8 Location

7/22 8" @ 215 w/160
Miss 2958
5" @ 2959 $\frac{1}{2}$
DD 2970 TD
S/24 bo 36 hrs.

7/29 P/23 $\frac{1}{2}$ bopd

8/5 NR

8/12 "

8/19 "

9/16 "

9/23 Spud 7-8-53

Oil Well

TD 2970'

8" @ 215'

Miss. 2958,

5" @ 2959'

DD 2970 S/ 24 bo 36 hr. P/ 23 $\frac{1}{2}$

bopd P/ 16 bopd 2% wtr. 500 A

P/ 22 bopd 6 bw.

Comp. 27 bopd.

COMPLETED

County McPherson State Kansas

Sec. **21** (Blk. **19** (Sur. **2W** Map No.

Operator Geo. Hess, et al.

Well No. 1 Farm Wedel

Elev.	Location	SW	SW	SW
-------	----------	----	----	----

0

330 Ft. From S Line SIDE

330 Ft. From W Line Quarter

1st. Report JUL 8 1953

Completion

Remarks

Mallard Drlg. - Contr.

Spudding Date

Drlg. Data Lively

Location

J. G. McGEHEE

Map No. _____ Sec. 22 Twp. 19 R. 2WWell No. 1 Wedel


Geo. Hess, etal.

Company

Contractor

SW SW SW

SECTION PLAT

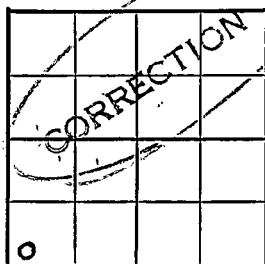

_____ Ft. from N. Line

330 Ft. from S. Line

_____ Ft. from E. Line

330 Ft. from W. Line

Location _____

Rig up _____

Drilling and Remarks:

Reported

21-19-2W

RECORD

Cased _____ in., _____ ft.

Sand _____

Gas _____

Oil _____

Total Depth _____

PRODUCTION

1st 24 hrs. Nat. _____

1st 24 hrs. after shot _____

Gas _____ Cu. Ft.

Dry Hole _____

Abandoned _____

Date

JUL 14 1953
19

J.G. McPHEE

Scout

County McPherson State Kansas

Sec. 22 (Blk. Twp.) 19 (Sur. Rge.) 2W Map No.

Operator Geo. Hess et al.

Well No. 1 Farm Wedel

Elev.	1548	Location	SW SW SW
-------	------	----------	----------

COMPLETE

330 Ft. From S Line SW

330 Ft. From W Line Quarter

1st. Report

Completion SFP 23 1953

Remarks Lively Pool

Mallard Drlg. - Contr.

Spudding Date 7-8-53

Drq. Data Oil well TD 2970

8" @ 215 Miss. 2958 5" @ 2959

DD 2970 S/ 24 bo 36 hr. P/ 23 $\frac{1}{2}$ bopd

P/ 16 bopd 2% wtr. 500 A

P/ 22 bopd 6 bw Comp. 27 bopd