


Section 22 Township 19 Range 2W

Well No. 8 Galva Unit

Company Musgrove Petr.

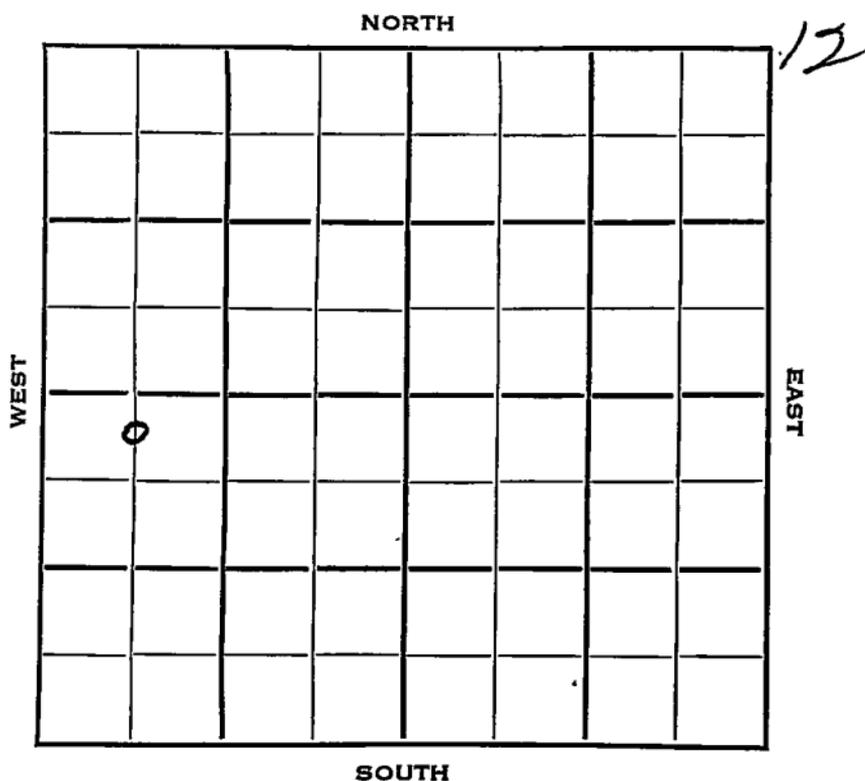



County McPherson State Kansas

Sec. 22 (Blk. Twp.) 19 (Sur. Rge.) 2W Map No.

Operator Musgrove Pet.

Well No. 8 Farm Galva Unit

Elev. \_\_\_\_\_ Location C N L NW SW


2380 Ft. From S Line SW

647 Ft. From W Line Quarter

1st. Report FEB 24 1954

Completion \_\_\_\_\_

Remarks \_\_\_\_\_

Musgrove - Contr.

Spudding Date 2-19-54

Drig. Data Lively Pool

8" @ 160 drig. 690

J. G. McGEHEE

