

Section 22 Township 19 Range 2 WWell No. # 5 Galva Unit #7Company Musgrove Pet.

NORTH

12

SOUTH

WEST

EAST

0

McPherson KANSAS

SEC. 22	TWP. 19	R. 2W ✓
------------	------------	------------

WELL NO.

5 Galva Unit #7

FARM

COMPANY

Musgrove Petr.

CONTRACTOR

Musgrove


Lively Pool

859 Ft. from N. Line

Ft. from S. Line

Ft. from E. Line

1080 Ft. from W. Line

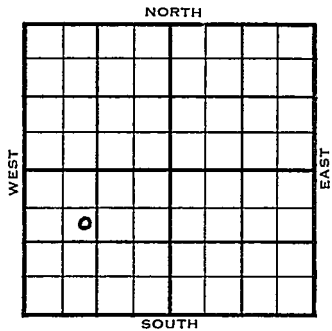


SE NW SW

	ELEVATION	REPORT
1953	1547'	
11/24	Spud 11-22-53 8" @ 159'	
12/30	Spud 11-22-53 Oil well TD 2952 8" @ 159 Miss 2947' Solid Miss 2948 TD 2950 4" @ 2948 CO to 2950 S/3 BOPH DD 2952 S/5½ BOPH 3 hr. Hydro. S/14 BOPH Comp. 250 BOPD	

COMPLETED

County McPherson State Kansas
 Sec. 22 (Blk. 19 (Sur. 2W Map No. (Twp.) Rge.)
 Operator Musgrove Pet.
 Well No. 5 Farm Galva Unit #7
 Elev. 1547 Location SE NW SW

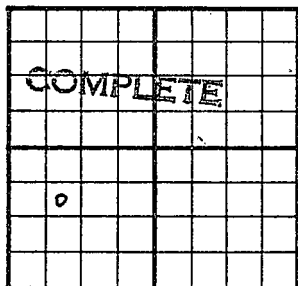

859 Ft. From N Line SW
1080 Ft. From W Line Quarter
 1st. Report
 Completion DEC 30 1953
 Remarks Lively Pool
Musgrove - Contr.
 Spudding Date 11-22-53

Drilg. Data Oil well TD 2952
8" @ 159 Miss. 2947 Solid Miss. 2948
TD 2950 4" @ 2948 CO to 2950
S/ 3 boph DD 2952 S/ 5 $\frac{1}{2}$ boph 3 hr.
Hydro. S/ 14 boph Comp. 250 bopd

J. G. McGEHEE