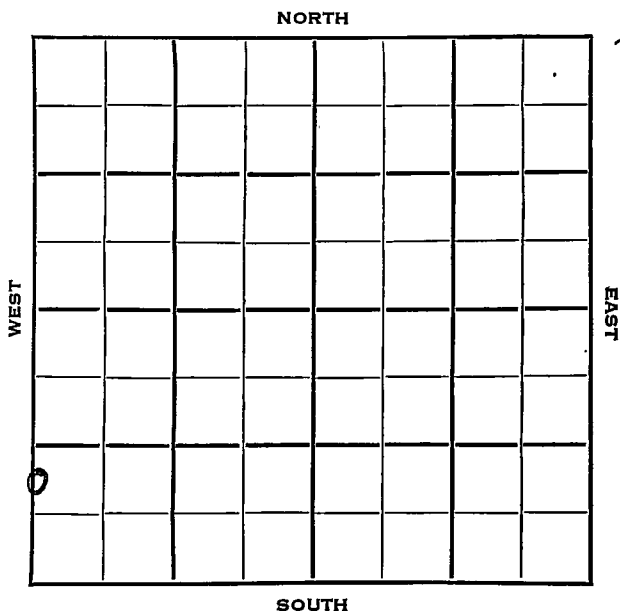


Section 22 Township 19 Range 2 WWell No. # 4 Galva Unit #4Company Musgrove Pet.

McPherson

KANSAS

|      |      |     |
|------|------|-----|
| SEC. | TWP. | R.  |
| 22   | 19   | 2 W |

WELL NO.

# 4 Galva Unit #4

FARM

COMPANY

Musgrove Pet.

CONTRACTOR

Musgrove

Lively Pool


\_\_\_\_\_ Ft. from N. Line

960 \_\_\_\_\_ Ft. from S. Line

\_\_\_\_\_ Ft. from E. Line

150 \_\_\_\_\_ Ft. from W. Line

NW SW SW

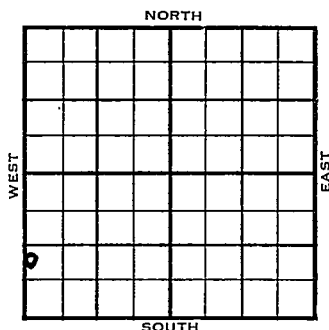

|       | ELEVATION   | REPORT |
|-------|---|--------|
| 1953  | 1539'   |        |
| 10/14 | Spud 10-8-53<br>8" @ 169   |        |
| 10/21 | Dr1g. 1838'<br>Miss 2944' RTD 2952'<br>5" @ 2950'   |        |
| 10/28 | CO 2952'<br>FU 1000' oil 3 hrs.<br>Sd-frac<br>S/5½ boph, 5 hrs.<br>POP                                                                                                |        |
| 11/4  | NR   |        |
| 11/11 | NR   |        |
| 11/18 | "   |        |
| 12/2  | Spud 10-8-53<br>Oil Well<br>TD 2952'<br>8" @ 169'<br>Miss 2944'<br>TD 2952'<br>5" @ 2950'<br>CO to 2952, FU 1000' oil, 3 hrs.<br>Sd-frac, S/5½ boph<br>Comp. 247 bopd |        |

COMPLETED

County **McPherson** State **Kansas**Sec. **22** (Blk. Twp.) **19** (Sur. Rge.) **2W** Map No.Operator **Musgrove Pet.**Well No. **4** Farm **Galva Unit #4**Elev. Location **NW SW SW**

|  |  |  |  |  |  |  |  |
|--|--|--|--|--|--|--|--|
|  |  |  |  |  |  |  |  |
|  |  |  |  |  |  |  |  |
960 Ft. From **S** Line **SW**150 Ft. From **W** Line **Quarter**1st. Report **OCT 14 1953**

Completion

Remarks

**Musgrove - Contr.**Spudding Date **10-8-53**Drlg. Data **Lively Pool****8" @ 169 drlg. 1838**

J. G. McGEHEE

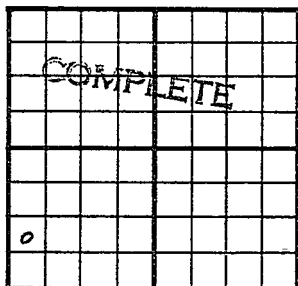County McPherson State KansasSec. 22 (Blk.  
Twp.) 19 (Sur.  
Rge.) 2W Map No.Operator Musgrove Pet.Well No. 4 Farm Galva Unit #4Elev. 1539 Location NW SW SW960 Ft. From S Line SW150 Ft. From W Line Quarter1st. ReportCompletion DEC 2 1953Remarks Lively PoolMusgrove - Contr.Spudding Date 10-8-53Drlg. Data Oil well TD 29528" @ 169 Miss. 2944 TD 29525" @ 2950 CO to 2952 FU 1000' oil3 hr. sd-frac S/ 5½ bophComp. 247 bopd

J. G. McGEHEE