



Map No. KANSAS Sec. 22 Twp. 19 R. 2<sup>w</sup>

Well No. 1- Almore Farm  
Barnsdall & Texas Company


660 Ft. from N. Line

\_\_\_\_\_ Ft. from S. Line

660 Ft. from E. Line

\_\_\_\_\_ Ft. from W. Line

1930

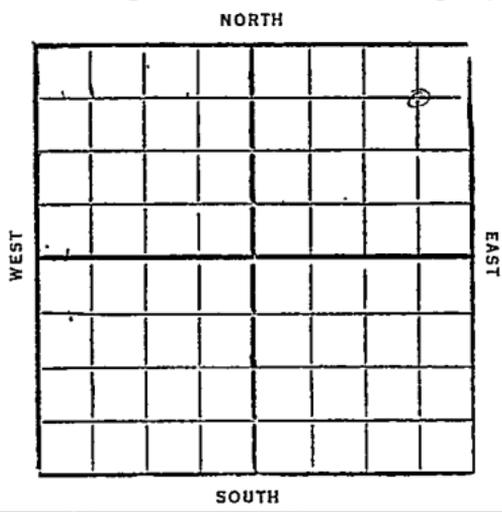

Date	REPORT
12/17	Log
12/23	Log
12/30	Bldg rig
1/31	Spud
1/17	Dry 1180'
1/21	" 2140
1/28	" 2288'
2/14	8" - 2550
	Dreg 2563
2/11	VIC 8" - 2770'
2/18	Top Chat 2934
	6" - 2931
	T.D. 2936' PBP.
2/20	Top Chat 2934
	Show oil & water 2974
	Lime (pay) 2994-96
	T.D. 2998
	Made 25 bbl 1 <sup>st</sup> 2 hrs
	" 25 " third hr
	" 30 " fourth hr.
	small sho water (over)

2/21- Deepened 2 feet  
T.D. 2998' lime  
Made 200 bbl 12 hr  
Pst 1/2 M gas  
slight show water  
may lower pipe

2/25- Sandy lime 2974-98  
T.D. 2998  
flow 207 bbl fluid  
35% water  
Comp.

1932 OWDD  
6/11- Old T.D. 2988  
(Top chat 2934)  
drlg 3100'

6/8- Top Viola 3402  
small show oil 3405  
SD 3405  
6/15- Had 175' oil & 1300' water  
at 3405

T.D. 3433 5" froze  
6/22- swab 10 bbl in Viola  
Wilcox 3464  
drlg 3478'

6/29- Top Viola 3402  
" Wilcox 3464-78  
" Silic lime 3512  
Water 3516-20  
TD 3522  
Abandon

*W. H. Peterson*  
 KANSAS  
 Map No. 43 Sec. 22 Twp. 19 R. 2W

Well No. 1 Re. Im. o. e.

Barnsdall Oil & Texas Company

Contractor

## SECTION PLAT

			0

660 Ft. from N. Line

..... Ft. from S. Line

660 Ft. from E. Line

..... Ft. from W. Line

## FIRST REPORTS

Location

Rig up .....

Drilling and Remarks:

## RECORD

Cased.....in., .....ft.

Sand.....

Gas.....

Oil.....

Total Depth.....

## PRODUCTION

1st 24 hrs. Nat.....

1st 24 hrs. after shot.....

Gas..... Cu. Ft.

Dry Hole.....

Abandoned.....

Date

DEC 17 1930

S. J. LEWIS

Scout

*W. J. ...*  
*...*

Returnsd.....	<i>[Signature]</i>
Cards.....	
Tracing.....	<i>[Signature]</i>
France Map.....	X
Scarborough Map.....	<i>[Signature]</i>
Moody Map.....	X
Scarborough Plat Book.....	
Moody Plat Book.....	

Map No. KANSAS Sec. 22 Twp. 19 R. 24Well No. 1 A & UnderBarnwell Oil & Texas Company

Contractor

## SECTION PLAT

			0

660 Ft. from N. Line

..... Ft. from S. Line

660 Ft. from E. Line

..... Ft. from W. Line

COMPLETED

Location.....

Rig up.....

Drilling and Remarks:

*Flow: 207 gph  
 fluid 30% water*

## RECORD

Cased..... in., ..... ft.

Sand line 2974-2998Gas 1/2 M

Oil.....

Total Depth 2998

## PRODUCTION

1st 24 hrs. Nat.....

1st 24 hrs. after shot.....

Gas..... Cu. Ft.

Dry Hole.....

Abandoned.....

Date

FEB 25 1931S. J. LEWIS Scout

*Handwritten scribbles and lines, possibly representing a signature or a large mark.*

Returned	<i>WJS</i>
Cards	<i>WJS</i>
Tracing	<i>WJS</i>
France Map	
Scarborough Map	<i>[scribble]</i>
Moody Map	
Scarborough Plat Book	
Moody Plat Book	

*M = Pherson*

*43*

**KANSAS**

Map No. \_\_\_\_\_ Sec. *22* Twp. *19* R. *7*<sup>W</sup>

Well No. *1* *Almere*

*Barnsdall & Texas* Company

Contractor

**FIRST REPORTS**


*660* Ft. from N. Line

\_\_\_\_\_ Ft. from S. Line

*660* Ft. from E. Line

\_\_\_\_\_ Ft. from W. Line

**SECTION PLAT**

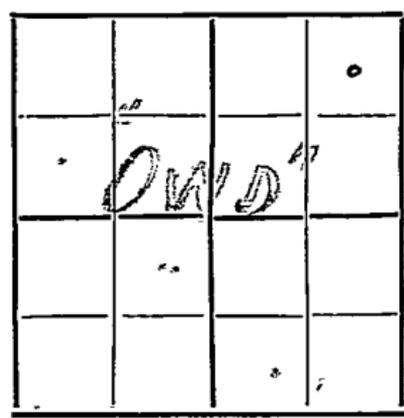

Location \_\_\_\_\_

Rig up \_\_\_\_\_

Drilling and Remarks:

*Top (hit) 2934  
OG TO 2988*

*OG 3100*

**RECORD**

Cased \_\_\_\_\_ in., \_\_\_\_\_ ft.

Sand \_\_\_\_\_

Gas \_\_\_\_\_

Oil \_\_\_\_\_

Total Depth \_\_\_\_\_

**PRODUCTION**

1st 24 hrs. Nat. \_\_\_\_\_

1st 24 hrs. after shot \_\_\_\_\_

Gas \_\_\_\_\_ Cu. Ft.

Dry Hole \_\_\_\_\_

Abandoned \_\_\_\_\_

Date

**JUN 1 1932**

**CHAS. L. SHERWOOD**

Scout

W. J. ...  
H. ...

Returned	
Cards	
Tracing	<i>OK</i>
France Map	<i>X</i>
Scarborough Map	<i>X</i>
Moody Map	<i>X</i>
Scarborough Plat Book	
Moody Plat Book	

*McPherson*

**43 KANSAS**

Map No. \_\_\_\_\_ Sec. *22* Twp. *19* R. *2* <sup>W</sup>

Well No. *1* *Almore*

*Barnsdall & Texas Co* Company

Contractor

**COMPLETED**

**SECTION PLAT**

*660* Ft. from N. Line

\_\_\_\_\_ Ft. from S. Line

*660* Ft. from E. Line

\_\_\_\_\_ Ft. from W. Line

**ABANDONED**

			<i>0</i>

Location \_\_\_\_\_

Rig up \_\_\_\_\_

Drilling and Remarks:

*Top Viola 3402*

*Milcox 3464-78*

*Top Siliceous 3512*

*Water 3516-20*

**RECORD**

Cased \_\_\_\_\_ in., \_\_\_\_\_ ft.

Sand \_\_\_\_\_

Gas \_\_\_\_\_

Oil \_\_\_\_\_

Total Depth *2522*

**PRODUCTION**

1st 24 hrs. Nat. \_\_\_\_\_

1st 24 hrs. after shot \_\_\_\_\_

Gas \_\_\_\_\_ Cu. Ft.

Dry Hole

Abandoned

Date

**JUN 29 1932**

**CHAS. L. SHERWOOD**

192

Scout

*[Large handwritten signature or scribble]*

Returned	<i>[Signature]</i>
Cards	<i>[Signature]</i>
Tracing	<i>[Signature]</i>
France Map	<i>[Signature]</i>
Scarborough Map	<i>[Signature]</i>
Moody Map	<i>[Signature]</i>
Scarborough Plat Book	
Moody Plat Book	