


Section 22 Township 19 Range 10-W

Well Number 1-Farmers & Bankers Ins. Co.

Company Simpson & Noble

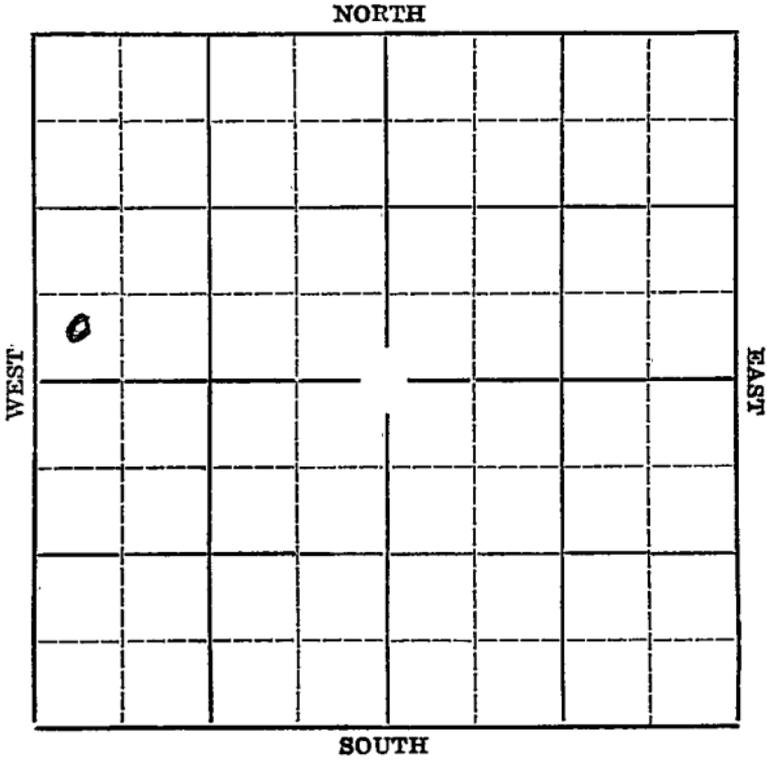

KANSAS

Map No. \_\_\_\_\_ Sec. 22 Twp. 19 R. 10-W

Well No. 1-Farmers & Bankers Life Ins. Co.  
Simpson & Noble Company


\_\_\_\_\_ Ft. from N. Line

330 Ft. from S. Line

\_\_\_\_\_ Ft. from E. Line

330 Ft. from W. Line

Elev. 1757

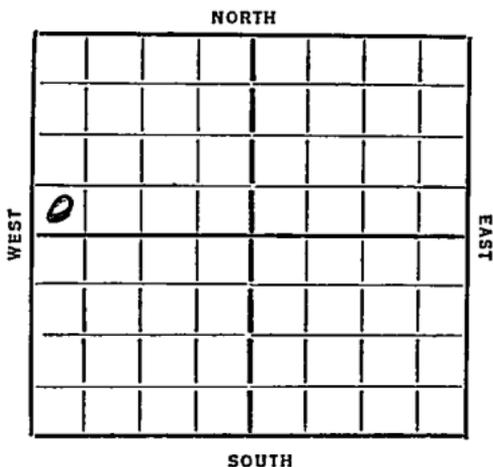

Date  
1936

REPORT

4/22 Location

4/30 -- 5/7--

5/14 Rig.

5/21 Rigging up.

5/28 Drlg. 2120'.

6/4 Drlg. 3049'. S.O. 3043-47'.

6/11 Sil. 3286'-94'. Show oil. Run 7" @ 3286'. Waiting on cement.

6/18 -- 6/25--

7/2 Bailing.

7/9 T.D. 3305'. Show water 3303-05'. Swab 34 bbls of oil in 8 hours. Plug back.

7/16 P.B. to 3297'. Water shut off. 1000' oil. Run tubing.

7/23 3000 gallons of acid. Pump 50 bbls of oil. 450 bbls of water.

**OVER**

7/29/36-Sil. '3286'.

~~Pl~~ P.D. 3305'.

Plug back 3296'.

3000 gallons of acid.

Potential 58 bbls of oil and  
10 bbls of water.

**COMPLETED**

**KANSAS**

Map No. 46 Sec. 22 Twp. 19 R. 10 W

Well No. 1 Farmers & Bankers Ins Co.

Simpson & Nettle Company  
 Contractor

**SECTION PLAT**

0			

..... Ft. from N. Line

330 Ft. from S. Line

..... Ft. from E. Line

330 Ft. from W. Line

**FIRST REPORT**

Location ✓.....

Rig up.....

Drilling and Remarks:

**RECORD**

Cased..... in., ..... ft.

Sand.....

Gas.....

Oil.....

Total Depth.....

**PRODUCTION**

1st 24 hrs. Nat.....

1st 24 hrs. after shot.....

Gas..... Cu. Ft.

Dry Hole.....

Abandoned.....

Date

APR 22 1936

S. J. LEWIS

192.....

Scout

10

11 1 1 1



at 10:00	
11	
12	
13	
14	
15	
16	
17	
18	
19	
20	

*[Handwritten signature]*

*[Handwritten signature]*

Map No. 46 Sec. 22 Twp. 19 R. 10W

Well No. 1 Farmers & Bankers

Simpson & Nothel Company

Contractor

SECTION PLAT

0			

\_\_\_\_\_ Ft. from N. Line

330 Ft. from S. Line

\_\_\_\_\_ Ft. from E. Line

330 Ft. from W. Line

COMPLETED

Location \_\_\_\_\_

Rig up \_\_\_\_\_

Drilling and Remarks:

*Sil 8286*  
*P.B. 3296.*  
*3000 acid*  
*P 858 Oil*  
*10 Water.*

RECORD

Cased \_\_\_\_\_ in., \_\_\_\_\_ ft.

Sand \_\_\_\_\_

Gas \_\_\_\_\_

Oil \_\_\_\_\_

Total Depth 3305

PRODUCTION

1st 24 hrs. Nat. \_\_\_\_\_

1st 24 hrs. after shot \_\_\_\_\_

Gas \_\_\_\_\_ Cu. Ft.

Dry Hole \_\_\_\_\_

Abandoned \_\_\_\_\_

Date

JUL 29 1936

S. J. LEWIS Scout

*[Large handwritten scribble]*

Returned	<i>[Signature]</i>
Cards	<i>[Signature]</i>
Tracing	<i>[Signature]</i>
France Map	<i>[Signature]</i>
Scarborough Map	<i>[Signature]</i>
Moody Map	<i>[Signature]</i>
Scarborough Handbook	
Moody Flat Book	