


Section 22 Township 19 Range 13W

Well No. 2 Esfeld "B"

Company Honaker Drig.

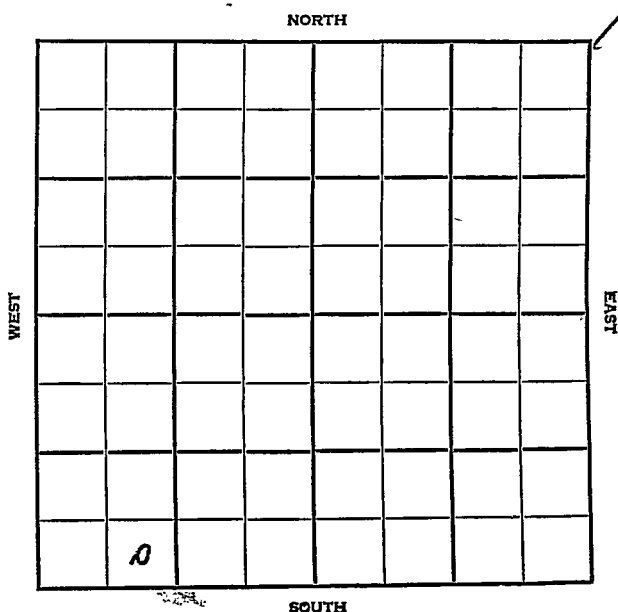

Barton

KANSAS

SEC.	TWP.	R.
22	19	13W

WELL NO.

2 Esfeld "B"

FARM

COMPANY

Honaker Drlg.

CONTRACTOR

Hilton Drlg. & Contr


Gt. Bend Townsite Pool

_____ Ft. from N. Line

330 _____ Ft. from S. Line

_____ Ft. from E. Line

990 _____ Ft. from W. Line

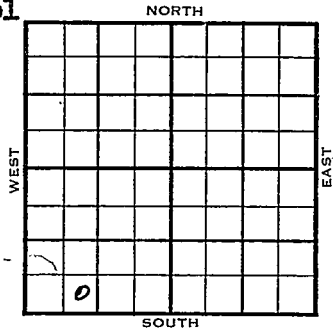

SE SW SW

1954	ELEVATION	REPORT
	1847	

6/2 Location
 6/9 8" @ 741 w/450
 Anhy 732'
 Drlg. 1485'
 8-11 Oil well
 TD 3470
 8" @ 741
 Anhy 732 Top/ 2815 Heeb. 3052
 Br. lime 3153 Lans. 3164
 DST 3168-3216 open 1 hr. Rec. 160' ho
 & gcm 110#
 DST 3225-40 open 1 hr. Rec. 1230' sw
 860#
 DST 3307-19 open 1 hr. Rec. 60' so &
 gcm 350#
 Arb. 3429
 DST 3431-38 open 1 hr. Rec. 2500' gas
 470' gco 630#
 TD 3470
 5" @ 3469 CO to 3460 21/31 32-37
 FU 175' oil 1/2 hr. 500 A S/ 27 boph
 VSSW Comp. 68 bopd

COMPLETED

