

Section 22 Township 19 Range 14WWell No. #1 ClarkCompany Brack, Inc.

NORTH

							0

WEST

EAST

SOUTH

Barton

KANSAS

19

14W

Sec. 22 Twp. R.

Well No. #1 Clark Farm

Brack, Inc. Company

Contractor


Wildcat
330' Ft. from N. Line

Ft. from S. Line

330' Ft. from E. Line

Ft. from W. Line

NE NE NE

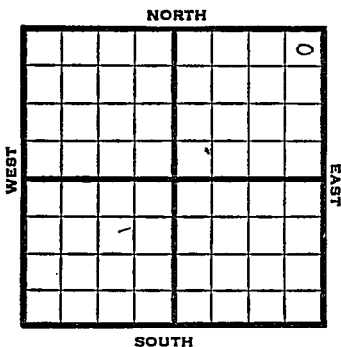

1950

Elev 1876' REPORT

3/15

Location

5/3

TD 3522'

8 5/8" @ 812'

Arb. 3510'

5 1/2" @ 3511'

D&A

Aband.

ABANDONED

Map No. _____ Sec. 22 Twp. 19 R. 14WWell No. 1 Clark_____Brack Inc._____
Company_____
Contractor

NE NE NE

SECTION PLAT

330

Ft. from N. Line

Ft. from S. Line330

Ft. from E. Line

Ft. from W. Line

Barton County

Location X

Rig up _____

Drilling and Remarks:

RECORD

Cased _____ in., _____ ft.

Sand _____

Gas _____

Oil _____

Total Depth _____

PRODUCTION

1st 24 hrs. Nat. _____

1st 24 hrs. after shot _____

Gas _____ Cu. Ft.

Dry Hole _____

Abandoned _____

Date


MAR 15 1950 19 J. E. TYRA Scout

Kansas

Wildcat

Map No. _____ Sec. 22 Twp. 19 R. 14WWell No. 1 Clark_____
Brack Inc. _____ Company_____
Contractor

NE NE NE

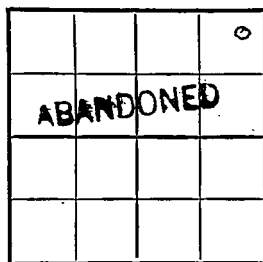El. 1876
SECTION PLAT330 Ft. from N. Line_____
Ft. from S. Line330 Ft. from E. Line_____
Ft. from W. Line

Barton County

Location _____

Rig up _____

Drilling and Remarks:

*8 5/8" @ 812**arb 3510**5 1/2" @ 3511**D + A*

RECORD

Cased _____ in., _____ ft.

Sand _____

Gas _____

Oil _____

Total Depth 3522

PRODUCTION

1st 24 hrs. Nat. _____

1st 24 hrs. after shot _____

Gas _____ Cu. Ft.

Dry Hole _____

Abandoned _____

Date

MAY 3 1950
19

J. E. TYRA

Scout