

KANSAS


Barton

FORM 51 5M 1-42 PETROL

Section 22 Township 19 Range 15-W

Well No. #1 Beals GAGLEMAN

Company Falcon-Seaboard

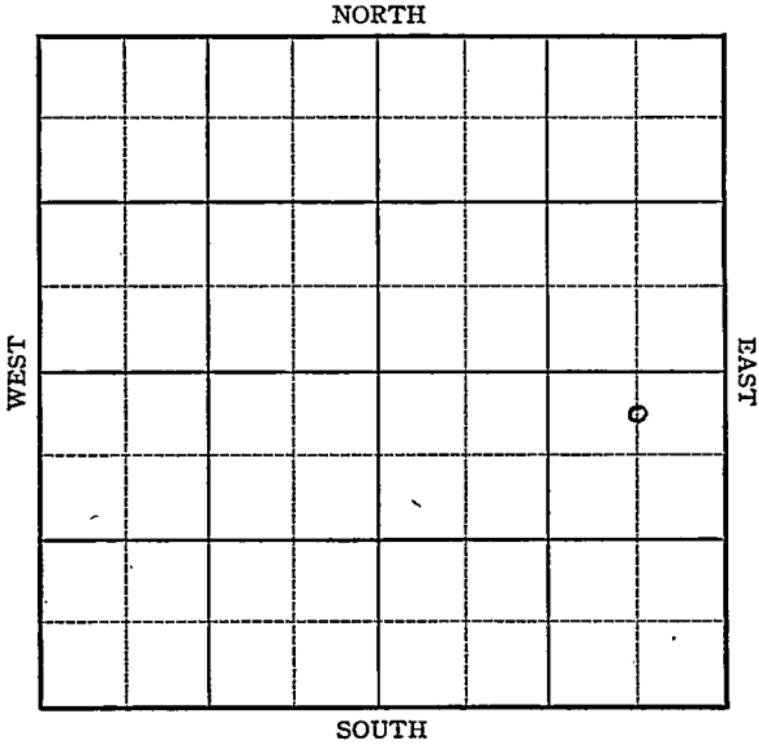

Sec. 22 Twp. 19 R. 15-W

Well No. #1 Beals GAGLEMAN Farm
Falcon-Seaboard Company


330 Ft. from N. Line

_____ Ft. from S. Line

660 Ft. from E. Line

_____ Ft. from W. Line

Elev. 1921

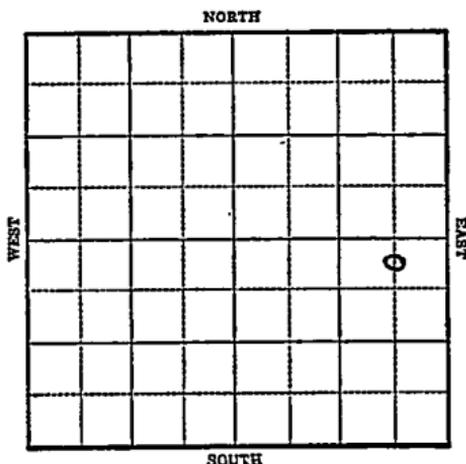

1944

R E P O R T

| | |
|------|--|
| 1-12 | Location |
| 1/19 | Derrick |
| 1/26 | 12" @ 115 Drlg. 310 |
| 2/2 | 8" @ 710 Anhy 880 Drlg. 1885 |
| 2/8 | Drlg. 2980 |
| 2/15 | Topeka 2910 Lans 3251 TD 3426 |
| 2/23 | SO 3417-22 Arb 3583 Reagan 3610 TD 3628 |

ABANDONED

KANSAS

Map No. 82 Sec. 22 Twp. 19 R. 15W

Well No. 1 Beals

Falcon-Seaboard Company

FIRST REPORT

Contractor

C N L NE SE


SECTION PLAT

330 Ft. from N. Line

_____ Ft. from S. Line

660 Ft. from E. Line

_____ Ft. from W. Line

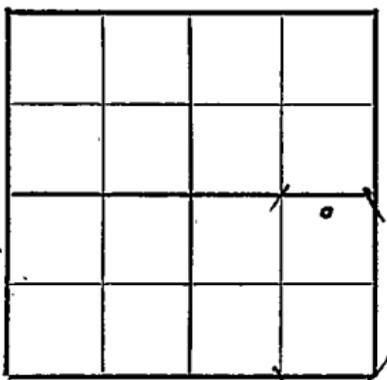

Wildcat

Location X

Rig up _____

Drilling and Remarks:

RECORD

Cased _____ in., _____ ft.

Sand _____

Gas _____

Oil _____

Total Depth _____

PRODUCTION

1st 24 hrs. Nat. _____

1st 24 hrs. after shot _____

Gas _____ Cu. Ft.

Dry Hole _____

Abandoned _____

Date

JAN 12 1944

19

S. J. LEWIS

Scout

KANSAS

Map No. _____ Sec. 22 Twp. 19 R. 15W

Well No. 1 Gagleman

Falcon Seaboard Company

CORRECTION Contractor

C N L NE SE

SECTION PLAT

330 Ft. from N. Line

_____ Ft. from S. Line

660 Ft. from E. Line

_____ Ft. from W. Line

| | | | |
|--|--|--|--|
| | | | |
| | | | |
| | | | |
| | | | |

Wild cat

Location _____

Rig up _____

Drilling and Remarks:

Reported as
#1 Beals

RECORD

Cased _____ in., _____ ft.

Sand _____

Gas _____

Oil _____

Total Depth _____

PRODUCTION

1st 24 hrs. Nat. _____

1st 24 hrs. after shot _____

Gas _____ Cu. Ft.

Dry Hole _____

Abandoned _____

Date

JAN 26 1944 19

S. J. LEWIS Scout

KANSAS

Map No. 82 Sec. 22 Twp. 19 R. 15W

Well No. 1 Gagleman

Falcon-Seaboard Company

ABANDONED Contractor

C N L N E S E

SECTION PLAT

330 Ft. from N. Line

_____ Ft. from S. Line

660 Ft. from E. Line

_____ Ft. from W. Line

| | | | |
|--|--|--|--|
| | | | |
| | | | |
| | | | |
| | | | |

Wildcat

Location _____

Rig up _____

Drilling and Remarks:

*Cr 3583
Reagan 3610*

RECORD

Cased _____ in., _____ ft.

Sand _____

Gas _____

Oil _____

Total Depth 3628

PRODUCTION

1st 24 hrs. Nat. _____

1st 24 hrs. after shot _____

Gas _____ Cu. Ft.

Dry Hole _____

Abandoned _____

Date'

FEB 23 1944 19

S. J. LEWIS Scout