FORM 51 10M 8-47


KANSAS Barton

Section 23 Township 19 Range ~~11W~~

Well No. #1 Isern

Company Ferrell Drlg.

Silica Pool

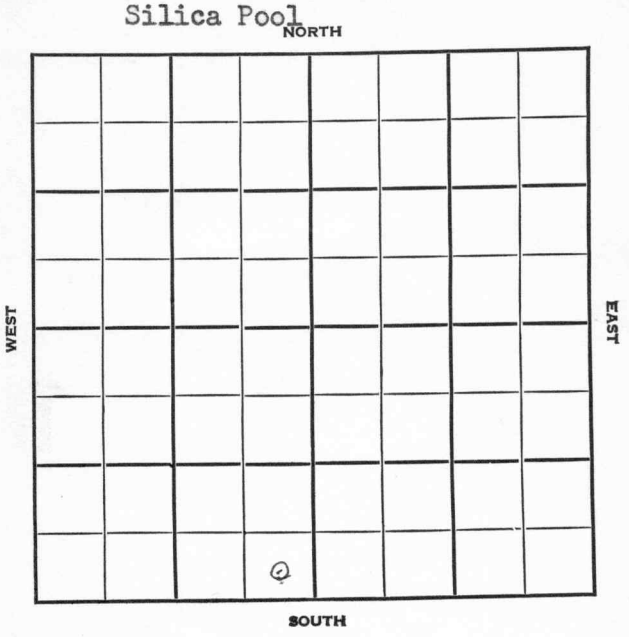

FORM 252-A
5M 12-45 PETROL


Barton KANSAS

Sec. 23 Twp. 19 R. 11W

Well No. #1 Isern Farm

Ferrell Drlg. Company

Silica

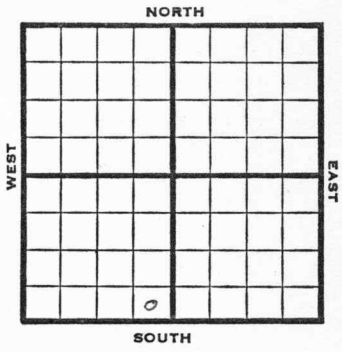

____ Ft. from N. Line

330 Ft. from S. Line

330 Ft. from E. Line

____ Ft. from W. Line

SE SW

1948	Elev. 1774' REPORT
4/7	8" @ 230' Anhy. 525' Drlg. 2134'
4/14	Lans. 3033' Gong. 3329' 3368' in Cong. TD 3368' Abd.

ABANDONED

Form 26—200 Bks.—1-48—Palace

Kansas

Silica Pool

Map No._____ Sec. 23 Twp. 19 R. 11W


Well No. 1 Isern

Ferrell Drlg. Company

FIRST REPORT Contractor

SE SW

SECTION PLAT

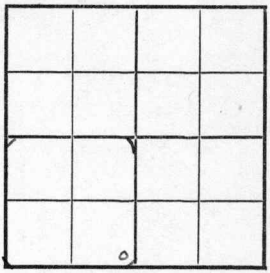

_____ Ft. from N. Line

330 Ft. from S. Line

330 Ft. from E. Line

_____ Ft. from W. Line

Barton County

Location _____

Rig up _____

Drilling and Remarks:

8" @ 230
anhy 525
drlg. 2134

RECORD

Cased _____ in., _____ ft.

Sand _____

Gas _____

Oil _____

Total Depth _____

PRODUCTION

1st 24 hrs. Nat. _____

1st 24 hrs. after shot _____

Gas _____ Cu. Ft.

Dry Hole _____

Abandoned _____

Date

APR 7 1948 19____

S. J. LEWIS Scout

Form 26—200 Bks.—1-48—Palace

Silica Pool

Kansas

Map No. 46 Sec. 23 Twp. 19 R. 11W

Well No. 1 Isern


Ferrell Drlg. Company

ABANDONED Contractor

SE SW

El. 1774

SECTION PLAT

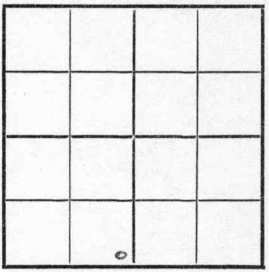

____ Ft. from N. Line

330 Ft. from S. Line

330 Ft. from E. Line

____ Ft. from W. Line

Barton County

Location

Rig up

Drilling and Remarks:

Lans 3833

Conq 3825

3868 in Conq

RECORD

Cased ____ in., ____ ft.

Sand

Gas

Oil

Total Depth 3868

PRODUCTION

1st 24 hrs. Nat.

1st 24 hrs. after shot

Gas ____ Cu. Ft.

Dry Hole

Abandoned

Date

APR 1 4 1948 19____ S. J. LEWIS Scout