

Kenton
23 19 11W

KANSAS

Map No. _____ Sec. 23 Twp. 19 R. 11W

Well No. 1- Zeigenbusch Farm

Zeyher Co. Company


330 Ft. from N. Line

_____ Ft. from S. Line

330 Ft. from E. Line

_____ Ft. from W. Line

Elev. 1780

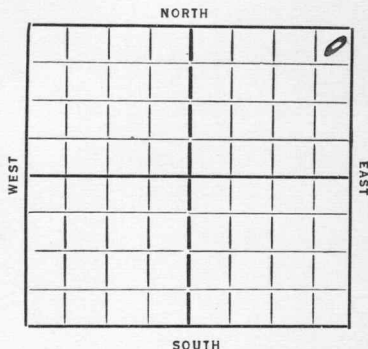

Date	REPORT
12/18	Location
12/26	Plot Rig
12/36	hr
1/19	dy 1890 18" 206
1/17	" 2950
1/24	Cored 3038-56 1/2 See the Oil
	T/C 3041 7" 3041 WOC
1/31	1 1/2 M Gas 3057 to 3061
	dy 3090
2/7	" 3198
2/14	" 3242
2/21	T Oil 3309 TD 3311
	WO pipe
2/28	Run 5" pipe
3/6	5" 3311 TD 3327 W R 5"
3/13	5" 3334 TD 3357
	Pay 3353-55
	1 barrel oil per hr 3340-46
	1350' oil 12 hrs.
3/18	Oil 3309 Pay 3353-55
	TD 3357 1000 acid
	Pot 188 Bbls.

COMPLETED

Map No. 46 Sec. 23 Twp. 19 R. 11W

Well No. 1-Zeigenbusch

Texas Co Company

Contractor

FIRST REPORTS

SECTION PLAT

330 Ft. from N. Line

..... Ft. from S. Line

330 Ft. from E. Line

..... Ft. from W. Line

			0

Location ✓

Rig up.....

Drilling and Remarks:

RECORD

Cased.....in.,ft.

Sand.....

Gas.....

Oil.....

Total Depth.....

PRODUCTION

1st 24 hrs. Nat.....

1st 24 hrs. after shot.....

Gas.....Cu. Ft.

Dry Hole.....

Abandoned.....

Date

ORVAL MANNSCHECK

12-18-35 192

Scout

Map No. 46 Sec. 23 Twp. 19 R. 11W

Well No. 1 - Ziegenbush
Texas Company

Contractor

COMPLETED

SECTION PLAT

			0

330 Ft. from N. Line

..... Ft. from S. Line

330 Ft. from E. Line

..... Ft. from W. Line

Location.....

Rig up.....

Drilling and Remarks:

1000 acid

Prod - 188 bbls

RECORD

Cased..... in., ft.

Sand sd 3309

~~Gas~~ Pay 3353-55

Oil.....

Total Depth 3357

PRODUCTION

1st 24 hrs. Nat.....

1st 24 hrs. after shot.....

Gas..... Cu. Ft.

Dry Hole.....

Abandoned.....

Date

MAR 18 1930

ORVAL MANNSCHRECK

Scout