


Section 23 Township 19 Range 11W

Well No. 1 Isern

Company Alpine Oil & Royalty

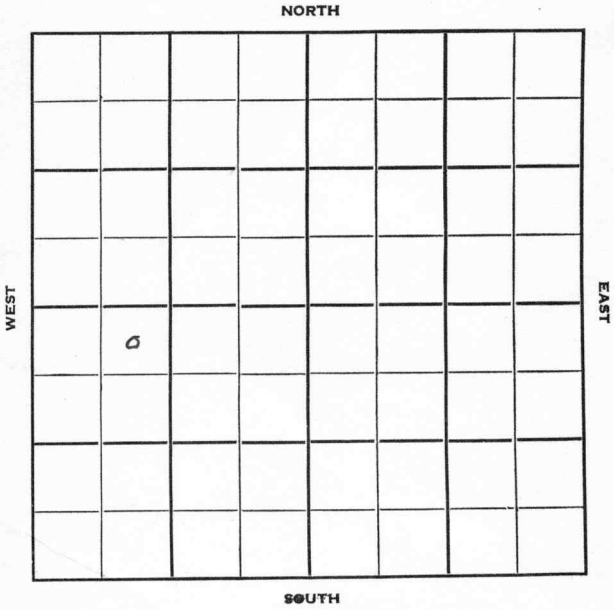

Barton

KANSAS

Sec. 23 Twp. 19 R. 11W

Well No. #1 Isern Farm

Alpine Oil & Royalty Company

Quaker Drlg. - Contr. Contractor


330' Ft. from N. Line

_____ Ft. from S. Line

_____ Ft. from E. Line

990' Ft. from W. Line

NE NW SW

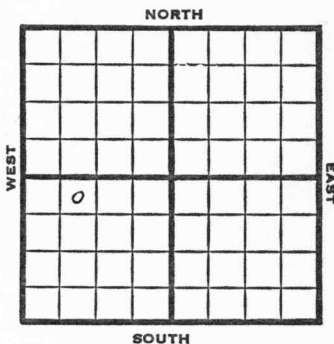

1951 Elev. 1774' REPORT

7/25 Spud 7-22-51

8" @ 225

Anhy 548

Drlg. 1150'

8/8 Spud 7-22-51

D&A TD 3430

8" @ 225 Anhy 548

Heeb. 2926 Br Lime 3045

Lans. 3059

DST 3295-3310 opn 1 hr

Rec. 5' mud Arb. 3358

TD 3430 D&A

ABANDONED

