

Section 23 Township 19 Range 11W

Well No. #1 Ziegenbush

Company Alpine Oil

NORTH

	0						

WEST

EAST

SOUTH

Barton

KANSAS

Sec. 23 Twp. 19 R. 11 W

Well No. # 1 Ziegenbush Farm

Alpine Oil Company

Quaker Contractor


330 Ft. from N. Line

_____ Ft. from S. Line

_____ Ft. from E. Line

990 Ft. from W. Line

NE NW NW

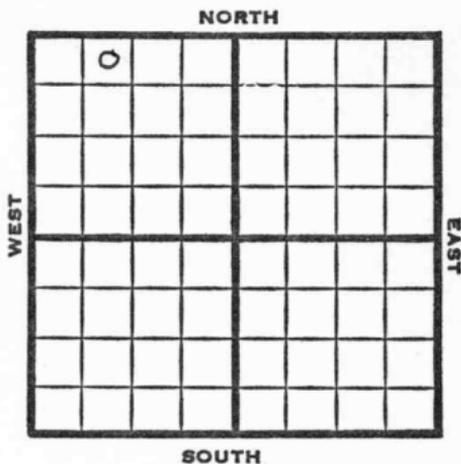

1951	Elev. 1780' REPORT
6/20	Spud 6-18-51 8" @ 228'
8/22	Spud 6-18-51 Oil well TD 3335' 8" @ 228 Anhy 545-85' Heeb 2914' Br. lime 3032' Lans. 3047' DST 3054-3122 open 40 min. rec 2500' gas 120' GCM DST 3137-48 open 1 hr. rec 55' mud DST 3212-3300 open 1 hr. rec 1560' gas 240' HGCM. Cong. 3326' Arb. 3330' 5" @ 3333 TD 3335' 33/3284-90 24/3288-94 500 A Comp. 30 BOPD <p style="text-align: center;">COMPLETED</p>

County **Barton** State **Kansas**

Sec. **23** (Bik. Twp.) **19** (Sur. Rge.) **11W** Map No.

Operator **Alpine Oil**

Well No. **1** Farm **Ziegenbush**

Elev. Location **NE NW NW**

o					
FIRST REPORT					

330 Ft. From **N** Line **NW**

990 Ft. From **W** Line Quarter

Ist. Report **JUN 20 1951**

Completion

Remarks

Quaker - Contr.

Spudding Date **6-18-51**

Drlg. Data

8" @ 228


County Barton State Kansas

Sec. 23 (Blk. 19) (Sur. Rge.) 11W Map No.

Operator Alpine Oil

Well No. 1 Farm Ziegenbush

Elev. 1780 Location NE NW NW

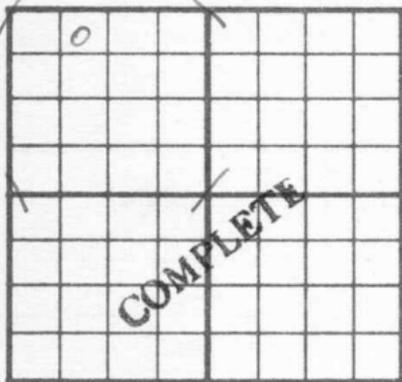

330 Ft. From N Line NW
990 Ft. From W Line Quarter

Ist. Report

Completion AUG 22 1951

Remarks

Quaker Drlg. - Contr.

Spudding Date 6-18-51

Drlg. Data Oil well TD 3335

8" @ 228 Anhy 545-85 Heeb. 2914

Br. lime 3032 Lans. 3047 DST 3054-

3122 open 40 min. Rec. 2500' gas

120' gcm DST 3137-48 open 1 hr.

Rec. 55' mud DST 3212-3300 open 1 hr.

Rec. 1560' gas 240' hgcm Cong. 3326

Arb. 3330 5" @ 3333 TD 3335

33/ 3284-90 24/ 3288-94 500 A

Comp. 30 bopd