


Barton

KANSAS

Section 23 Township 19 Range 11W

Well No. 2 Ziegenbusch

Company Texas

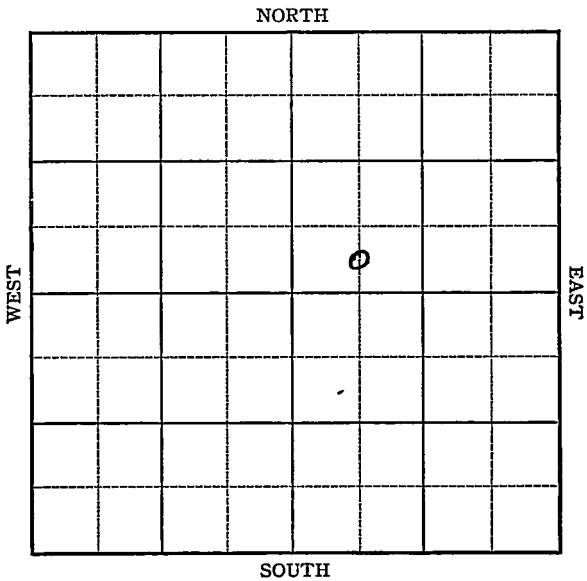

Map No. 46 Sec. 23 Twp. 19 R. 11WWell No. 2 ZiegenbuschTexas

Company

Contractor

FIRST REPORT

C S L SW NE

 Ft. from N. Line330 Ft. from S. Line Ft. from E. Line660 Ft. from W. Line

LANTERMAN POOL

SECTION PLAT

Location X

Rig up

Drilling and Remarks:

RECORD

Cased in., ft.Sand Gas Oil Total Depth

PRODUCTION

1st 24 hrs.-Nat. 1st 24 hrs. after shot Gas Cu. Ft.Dry Hole Abandoned

Date

JUN 11 1941

19

S. J. LEWIS

Scout

Map No. 4 Sec. 23 Twp. 19 R. 11WWell No. 2 Ziegenbusch

Texas

Company

ABANDONED

Contractor

SECTION PLAT

C S L SW NE


_____ Ft. from N. Line

330 Ft. from S. Line

_____ Ft. from E. Line

660 Ft. from W. Line

LANTERMAN POOL

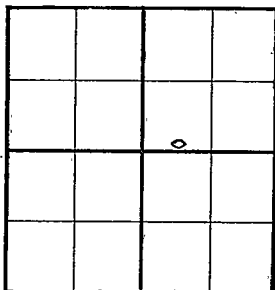

Location _____

Rig up _____

Drilling and Remarks:

*CR 43418**7 "C3358**Water*

RECORD

Cased _____ in., _____ ft.

Sand _____

Gas _____

Oil _____

Total Depth 3428

PRODUCTION

1st 24 hrs. Nat. _____

1st 24 hrs. after shot _____

Gas _____ Cu. Ft.

Dry Hole _____

Abandoned _____

Date

III 16 1941S. J. LEWIS

Scout