

Barton KANSAS

FORM 51 25M 3-49 PETROL

Section 23 Township 19 Range 12W
Well No. #7 Brodie
Company Aladdin Pet.

Hammer

NORTH

WEST

EAST

SOUTH

10

0

Sec. 23 Twp. 19 R. 12W ✓Well No. #7 Brodie Farm


Aladdin Pet.

Hammer Pool (Hannum Drlg. Contr.) Company

NORTH

990' Ft. from N. Line Ft. from S. Line Ft. from E. Line990' Ft. from W. Line

SE NW SE

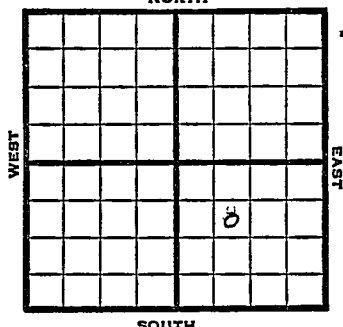

SOUTH

1949 Elev. 1809' REPORT

11/30	8" @ 238'
	Drlg. 1930'
12/7	Topeka 2726'
	Lansing 3108'
	Arb. 3378-90'
	TD 3390'
	5" @ 3381'
12/14	"
12/21	TD 3392'
	1000 acid
	Swb $4\frac{1}{2}$ bbls oil PH
12/28	"
1950	
1/25	8" @ 238'
	5" @ 3381'
	Lans 3108'
	Arb 3378'
	P 207 BOPD
	TD 3390'

COMPLETED

Map No. _____ Sec. 23 Twp. 19 R. 12W

Well No. 7 Brodie

Aladdin Pet. Company

Hannum Drlg. Contractor

SE NW SE


**FIRST REPORT
SECTION PLAT**

990 Ft. from N. Line

_____ Ft. from S. Line

_____ Ft. from E. Line

990 Ft. from W. Line

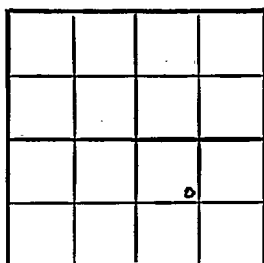

Barton County

Location _____

Rig up _____

Drilling and Remarks:

8" @ 238

drlg. 1930

RECORD

Cased _____ in., _____ ft.

Sand _____

Gas _____

Oil _____

Total Depth _____

PRODUCTION

1st 24 hrs. Nat. _____

1st 24 hrs. after shot _____

Gas _____ Cu. Ft.

Dry Hole _____

Abandoned _____

Date

NOV 30 1949 19

S. J. LEWIS Scout

Kansas

Map No. _____ Sec. 23 Twp. 19 R. 12WWell No. 7 BrodieAladdin Pet.

Company

Contractor

SE NW SE

E. 1809
SECTION PLAT990 Ft. from N. Line

_____ Ft. from S. Line

_____ Ft. from E. Line

990 Ft. from W. Line

COMPLETE			

Barton County

Location _____

Rig up _____

Drilling and Remarks:

8" @ 238

5" @ 3381

Lans 3108

arb 3378

P 207 BOPD

RECORD

Cased _____ in., _____ ft.

Sand _____

Gas _____

Oil _____

Total Depth 3390

PRODUCTION

1st 24 hrs. Nat. _____

1st 24 hrs. after shot _____

Gas _____ Cu. Ft.

Dry Hole _____

Abandoned _____

Date

JAN 25 1950

19

J. E. TYRA

Scout