

Sec. 23 Twp. 19 R. 12W

Well No. #8 Brodie Farm

Aladdin Pet. Company


Hammer Pool (Hannum, Contr.)

_____ Ft. from N. Line

330' Ft. from S. Line

990' Ft. from E. Line

_____ Ft. from W. Line

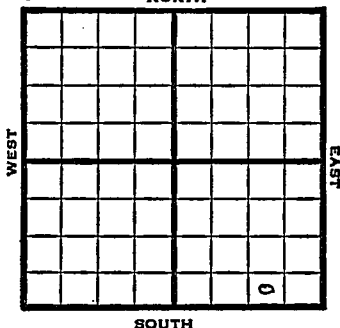

SW SE SE

1949 Elv. 1807' REPORT

12/21 8" @ 227'

12/28 Drlg 2900'

1950

1/25 8" @ 227'

5" @ 3351'

Arb 3349'

P 216 BOPD, 2% wtr

TD 3552'

COMPLETED

Kansas

Map No. _____ Sec. 23 Twp. 19 R. 12W

Well No. 8 Brodie

Aladdin Pet. _____ Company

Hannum _____ Contractor

SW SE SE

FIRST REPORT SECTION PLAT

			o

_____ Ft. from N. Line

330 Ft. from S. Line

990 Ft. from E. Line

_____ Ft. from W. Line

Barton County

Location _____

Rig up _____

Drilling and Remarks:

8" @ 227

RECORD

Cased- _____ in., _____ ft.

Sand _____

Gas _____

Oil _____

Total Depth _____

PRODUCTION

1st 24 hrs. Nat. _____

1st 24 hrs. after shot _____

Gas _____ Cu. Ft.

Dry Hole _____

Abandoned _____

Date

DEC 21 1949 19

S. J. LEWIS

Scout

Kansas

Map No. _____ Sec. 23 Twp. 19 R. 12W

Well No. 8 Brodie

Aladdin Pet. _____ Company

Contractor

SW SE SE

E. 1807
SECTION FLAT

_____ Ft. from N. Line

330 Ft. from S. Line

990 Ft. from E. Line

_____ Ft. from W. Line

COMPLETE			
			o

Barton County

RECORD

Location _____

Cased _____ in., _____ ft.

Rig up _____

Sand _____

Drilling and Remarks:

Gas _____

Oil _____

Total Depth 3552

8" @ 227
5" @ 3351
arb 3349
P 216 BOPD
2% wtr.

PRODUCTION

1st 24 hrs. Nat. _____

1st 24 hrs. after shot _____

Gas _____ Cu. Ft.

Dry Hole _____

Abandoned _____

Date

J. E. TYRA

JAN 25 1950 19

Scout