

# KANSAS

Barton

Section 23 Township 19 Range 12W

Well No. 1 Stuezhaman

Company N C R A & Sohio

Hammer

NORTH

WEST

EAST

				0			

SOUTH

7

Sec. 23 Twp. 19 R. 12W

Well No. #1 Stuezhaman Farm

N C R A & Sohio Company

Hammer Pool (Hannum, Cont.) NORTH


\_\_\_\_\_ Ft. from N. Line  
330'

\_\_\_\_\_ Ft. from S. Line

\_\_\_\_\_ Ft. from E. Line

330' Ft. from W. Line

SW NE

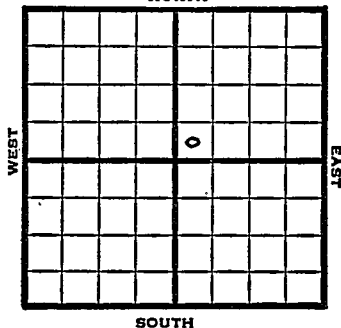

1949 Elev 1816' REPORT

- 10/19 8" @ 234'
- 10/26 Drlg. - 2500'
- 11/1 Arbuckle 3381'  
TD 3383'  
5" @ 3382'
- 11/9 TD 3407'  
SO&W  
PB 3405 - 250 acid
- 11/16 Swb 3 1/2 bbls oil PH 8 hrs.
- 11/23 "
- 11/29 "
- 12/7 TD 3407'  
Arb. 3381'  
5" @ 3382'  
1750 acid  
Pump 46 Oil / 40% W Pot  
39<sup>9</sup> Gr.  
Comp

**COMPLETED**

Kansas

Map No. \_\_\_\_\_ Sec. 23 Twp. 19 R. 12W

Well No. 1 Stuezhaman

N C R A & Sohio Company

Hannum Contractor

SW NE


FIRST REPORT SECTION PLAT

\_\_\_\_\_ Ft. from N. Line

330 Ft. from S. Line

\_\_\_\_\_ Ft. from E. Line

330 Ft. from W. Line

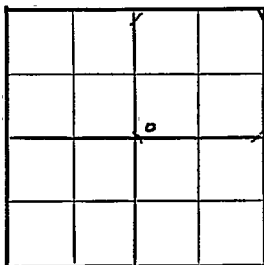

Barton County

RECORD

Location \_\_\_\_\_

Cased \_\_\_\_\_ in., \_\_\_\_\_ ft.

Rig up \_\_\_\_\_

Sand \_\_\_\_\_

Drilling and Remarks:

Gas \_\_\_\_\_

Oil \_\_\_\_\_

Total Depth \_\_\_\_\_

8" @ 234

PRODUCTION

1st 24 hrs. Nat. \_\_\_\_\_

1st 24 hrs. after shot \_\_\_\_\_

Gas \_\_\_\_\_ Cu. Ft.

Dry Hole \_\_\_\_\_

Abandoned \_\_\_\_\_

Date

OCT 19 1949 19

S. J. LEWIS Scout

Kansas

Map No. \_\_\_\_\_ Sec. 23 Twp. 19 R. 12W

Well No. 1 Stuezheman

NCRA & Sohio Company

COMPLETE

Contractor

SW NE

E. 1976.

SECTION PLAT

\_\_\_\_\_ Ft. from N. Line

330 Ft. from S. Line

\_\_\_\_\_ Ft. from E. Line

330 Ft. from W. Line

		4	

Barton County

Location \_\_\_\_\_

Rig up \_\_\_\_\_

Drilling and Remarks:

*Core 3381  
5" core  
1750 core*

*Pump 46 oil + 40%  
P.D.*

*29 3/4*

RECORD

Cased \_\_\_\_\_ in., \_\_\_\_\_ ft.

Sand \_\_\_\_\_

Gas \_\_\_\_\_

Oil \_\_\_\_\_

Total Depth 3407

PRODUCTION

1st 24 hrs. Nat. \_\_\_\_\_

1st 24 hrs. after shot \_\_\_\_\_

Gas \_\_\_\_\_ Cu. Ft.

Dry Hole \_\_\_\_\_

Abandoned \_\_\_\_\_

Date

DEC 7 1949 19

S. J. LEWIS Scout