

# KANSAS

Barton


Section 23 Township 19 Range 12W

Well No. 4 Brodie

Company Aladdin Pet

Hammer  
NORTH

10

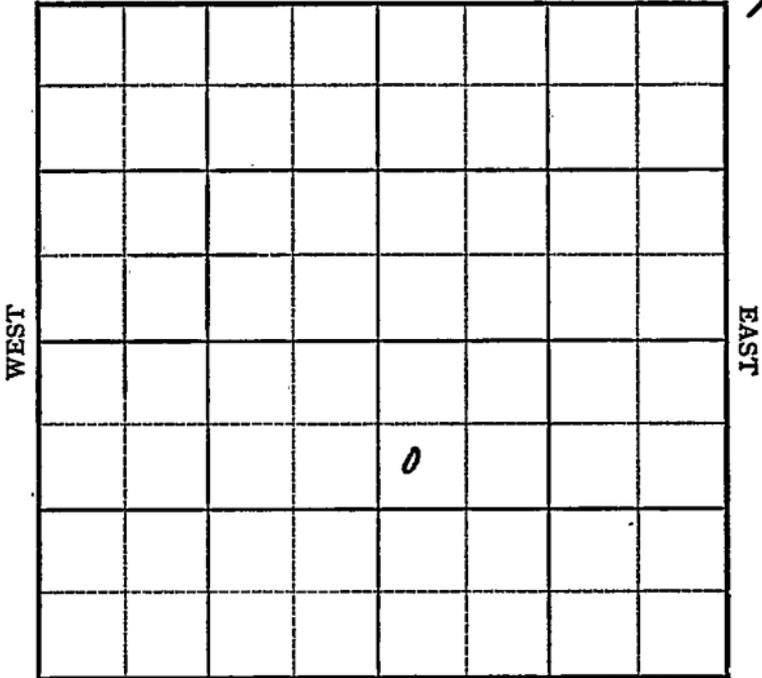

SOUTH

KANSAS

Barton

Sec. 23 Twp. 19 R. 12W ✓

Well No. #4 Brodie Farm \_\_\_\_\_

Aladdin Pet. Company \_\_\_\_\_


Hammer Pool

990' Ft. from N. Line

\_\_\_\_\_ Ft. from S. Line

\_\_\_\_\_ Ft. from E. Line

330' Ft. from W. Line

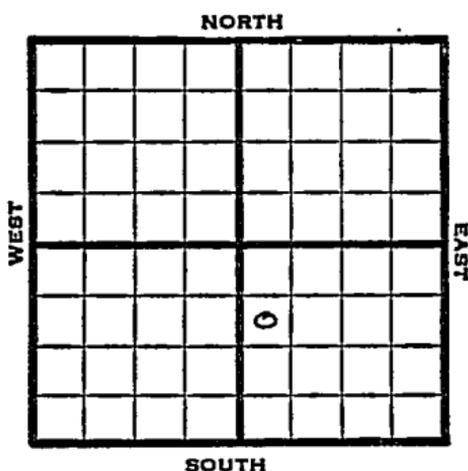

SW NW SE

1949

Elev 1811' REPORT

4/6

8" @ 237'

Anhy 622'

Drlg. 652'

4/12

Lansing 3103'

Drlg 3175'

4/20

Arb. 3354-58

TD 3358

5" @ 3357'

4/27

TD 3374'

Pump 4 bbls oil PH 7 hrs.

5/4

TD 3374'

Arb. 3354'

5" @ 3357'

Pump 206 oil / 2% W Pot

41° Gr.

Comp

**COMPLETED**

Map No. \_\_\_\_\_ Sec. 23 Twp. 19 R. 12W

Well No. 4 Brodie

Aladdin Pet. Company

**FIRST REPORT** Contractor

SW NW SE

**SECTION PLAT**

990 Ft. from N. Line

\_\_\_\_\_ Ft. from S. Line

\_\_\_\_\_ Ft. from E. Line

330 Ft. from W. Line

		6	

Barton County

Location \_\_\_\_\_

Rig up \_\_\_\_\_

Drilling and Remarks:

8" @ 237

Anhy 622

drlg. 652

**RECORD**

Cased \_\_\_\_\_ in., \_\_\_\_\_ ft.

Sand \_\_\_\_\_

Gas \_\_\_\_\_

Oil \_\_\_\_\_

Total Depth \_\_\_\_\_

**PRODUCTION**

1st 24 hrs. Nat. \_\_\_\_\_

1st 24 hrs. after shot \_\_\_\_\_

Gas \_\_\_\_\_ Cu. Ft.

Dry Hole \_\_\_\_\_

Abandoned \_\_\_\_\_

Date

APR 6 1949 19

S. J. LEWIS Scout

Map No. K 46 Sec. 23 Twp. 19 R. 12W

Well No. 4 Brodie

Aladdin Petroleum Company

**COMPLETE**

Contractor

SW NW SE

*E. J. Lewis*

**SECTION PLAT**

990 Ft. from N. Line

\_\_\_\_\_ Ft. from S. Line

\_\_\_\_\_ Ft. from E. Line

330 Ft. from W. Line

		0	

Barton County

**RECORD**

Location \_\_\_\_\_

Rig up \_\_\_\_\_

Drilling and Remarks:

*5-23-54*

*5-20-57*

*Produced 206 oil 72% water*

*Per*

*41 3/4*

Cased \_\_\_\_\_ in., \_\_\_\_\_ ft.

Sand \_\_\_\_\_

Gas \_\_\_\_\_

Oil \_\_\_\_\_

Total Depth *2324*

**PRODUCTION**

1st 24 hrs. Nat. \_\_\_\_\_

1st 24 hrs. after shot \_\_\_\_\_

Gas \_\_\_\_\_ Cu. Ft.

Dry Hole \_\_\_\_\_

Abandoned \_\_\_\_\_

Date

MAY 4 1949

19

S. J. LEWIS

Scout