

KANSAS

Barton

Section 23 Township 19 Range 12W

Well No. 1 Wagner

Company Aladdin Pet

Hammer
NORTH

14

WEST

EAST

SOUTH

0

Sec. 23 Twp. _____ R. _____

Well No. #1. Wagner Farm _____
Aladdin Pet. Company _____

Hammer Pool


_____ Ft. from N. Line

990' Ft. from S. Line

330' Ft. from E. Line

_____ Ft. from W. Line

NE SE SW

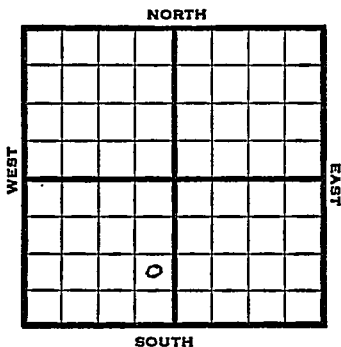

1949 Elev 1812' REPORT

2/23 Location
 3/2 8" @ 221'
 Drlg 1405'
 3/8 Lans. 3096'
 Drlg 3155'
 3;16 Arb 3366
 Swb 5 bbls oil PH 3 hrs.
 2000 acid
 3/23 "
 3/30 "
 4/6 Pump 238 bbls oil 24 hrs.
 4/12 "
 4/20 "
 4/20 TD 3366'
 Arb. 3348'
 5" @ 3351'
 2000 acid
 Pump 390 Oil Pot
 41⁷ Gr.
 Comp

COMPLETED

Map No. _____ Sec. 23 Twp. 19 R. 12W

Well No. 1 Wagner

Aladdin Pet. Company

FIRST REPORT Contractor

NE SE SW

SECTION PLAT

_____ Ft. from N. Line

990 Ft. from S. Line

330 Ft. from E. Line

_____ Ft. from W. Line

Barton County

Location X

Rig up _____

Drilling and Remarks:

RECORD

Cased _____ in., _____ ft.

Sand _____

Gas _____

Oil _____

Total Depth _____

PRODUCTION

1st 24 hrs. Nat. _____

1st 24 hrs. after shot _____

Gas _____ Cu. Ft.

Dry Hole _____

Abandoned _____

Date

FEB 23 1949 19

S. J. LEWIS Scout

Kalooka

Map No. K46 Sec. 23 Twp. 19 R. 12W

Well No. 1 Wagner

Aladdin Pet. Company

COMPLETE

Contractor

NE SE SW:

E11872
SECTION PLAT

_____ Ft. from N. Line

990 Ft. from S. Line

330 Ft. from E. Line

_____ Ft. from W. Line

Barton County

Location _____

Rig up _____

Drilling and Remarks:

Case 3348

5" @ 3351

2000 acid

Pump 390 oil Prod

H. J. Lewis

RECORD

Cased _____ in., _____ ft.

Sand _____

Gas _____

Oil _____

Total Depth 2366

PRODUCTION

1st 24 hrs. Nat. _____

1st 24 hrs. after shot. _____

Gas _____ Cu. Ft.

Dry Hole _____

Abandoned _____

Date

APR 27 1949 19

S. J. LEWIS Scout