

Section 23 Township 19 Range 12W

Well No. 2 Brodie

Company Aladdin Pet et al


No name

NORTH

WEST

EAST

SOUTH

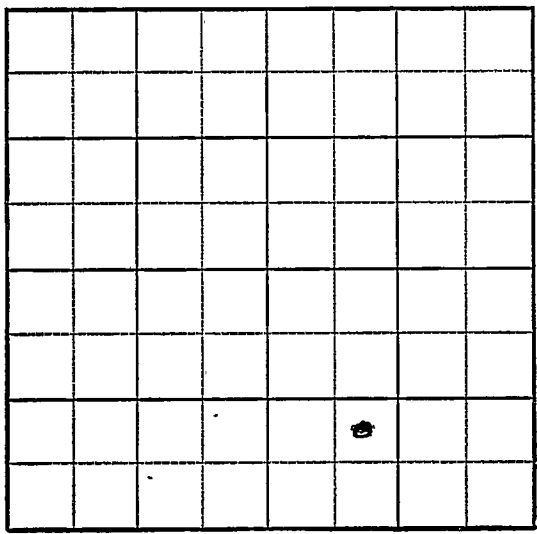

Barton

Sec. 23 Twp. 19 R. 12W ✓

Well No. #2 Brodie Farm

Aladdin Pet. et al Company

No Name

_____ Ft. from N. Line

990'


_____ Ft. from S. Line

_____ Ft. from E. Line

990'

_____ Ft. from W. Line

NE SW SE

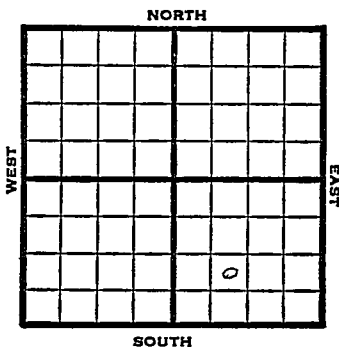

1949

Elev. 1809' REPORT

1/19 Location

1/26 "

2/2 RUR

2/9 "

2/16 8" @ 217'

2/23 Drlg 2948'

3/2 Lansing 3095'

Arb. 3353-55'

TD 3355'

5" @ 3354'

3/8 TD 3368

2000 acid

Pump 10 bbls oil PH

3/16 "

3/23 "

3/30 Arb 3353'

5" @ 3354' w/200' sks

Pump 476 Oil Pot.

Gr. 41°

TD 3368'

COMPLETED

Map No. _____ Sec. 23 Twp. 19 R. 12W

Well No. 2 Brodie

Aladdin Pet. etal. Company

FIRST REPORT Contractor

NE SW SE

SECTION PLAT

_____ Ft. from N. Line

990 Ft. from S. Line

_____ Ft. from E. Line

990 Ft. from W. Line

Barton County

Location X

Rig up _____

Drilling and Remarks:

RECORD

Cased _____ in., _____ ft.

Sand _____

Gas _____

Oil _____

Total Depth _____

PRODUCTION

1st 24 hrs. Nat. _____

1st 24 hrs. after shot _____

Gas _____ Cu. Ft.

Dry Hole _____

Abandoned _____

Date

JAN 19 1949 19

S. J. LEWIS Scout

Scout Cards	
Land Small Map	
Land Wall Map	
Tracings	
France Map	
Pierce Map	
Misc.	

Scout Cards
Land Small Map
Land Wall Map
Tracings
France Map
Pierce Map
Misc.