

KANSAS

Barton

Section 23 Township 19 Range 12W

Well No. 2 Wagner

Company Aladdin

Hammer

NORTH

14

WEST

EAST

0

SOUTH

Well No. #2 Wagner

Farm

Aladdin

Company

Hammer Pool

Ft. from N. Line


330'

Ft. from S. Line

330' Ft. from E. Line

Ft. from W. Line

SE SW

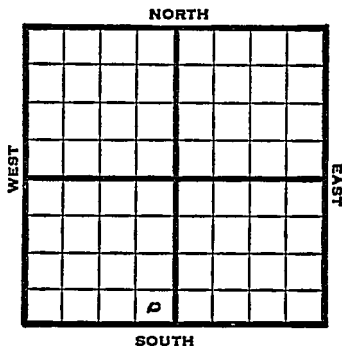

1949

Elev 1812' REPORT

3/9

Location

3/16

8" @ 222'
Drlg 2150'

3/23

Lansing 3104'
Arbuckle 3362'
TD 3365'
5" @ 3364'

3/30

98 shots 3086-3170
5000 acid

4/6

TD 3371
2000 acid

4/12

Pump 10 bbls oil a day

4/20

"

4/27

TD 3381' 1 bbl oil PH

5/4

"

5/10

"

5/18

"

5/25

TD 3381'
Arb. 3362'
5" @ 3364'
7000 acid
Pump 88 oil / 6% W Pot
41° Gr.
Comp

COMPLETED

Map No. _____ Sec. 23 Twp. 19 R. 12W

Well No. 2 Wagner

Aladdin Company

FIRST REPORT Contractor

SE SW

SECTION PLAT

_____ Ft. from N. Line

330 Ft. from S. Line

330 Ft. from E. Line

_____ Ft. from W. Line

Barton County

Location X

Rig up _____

Drilling and Remarks:

RECORD

Cased _____ in., _____ ft.

Sand _____

Gas _____

Oil _____

Total Depth _____

PRODUCTION

1st 24 hrs. Nat. _____

1st 24 hrs. after shot _____

Gas _____ Cu. Ft.

Dry Hole _____

Abandoned _____

Date

MAR 9 1949 19

S. J. LEWIS Scout

Kansas

Map No. K-46 Sec. 23 Twp. 19 R. 12W

Well No. 2 Wagner

Aladdin Company

COMPLETE

Contractor

SE SW

F11872

SECTION PLAT

_____ Ft. from N. Line

330 Ft. from S. Line

330 Ft. from E. Line

_____ Ft. from W. Line

Barton County

Location _____

Rig up _____

Drilling and Remarks:

Per #3362
5" @ 3364
7000 aad
Pump 550 ft
B.W. 02
412 cu

RECORD

Cased _____ in., _____ ft.

Sand _____

Gas _____

Oil _____

Total Depth 3351

PRODUCTION

1st 24 hrs. Nat. _____

1st 24 hrs. after shot _____

Gas _____ Cu. Ft.

Dry Hole _____

Abandoned _____

Date

MAY 25 1949 19..

S. J. LEWIS

Scout