

KANSAS Barton

Sec. 23 Twp. 19 R. 12W ✓

Well No. #5 Brodie Farm
Aladdin Pet.
Hammer Pool Company

_____ Ft. from N. Line


330'

_____ Ft. from S. Line

_____ Ft. from E. Line

990'

_____ Ft. from W. Line

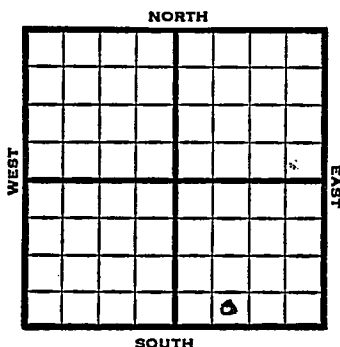

SE SW SE

SOUTH

1949

Elev. 1807'

REPORT

4/20

8" @ 220'

Anhy. 620'

Drlg. 1845'

4/27

Lansing 3095'

Drlg 3302'

5/4

Arb. 3345'

5" @ 3346'

TD 3347'

Plug 3235

48 shots 3217-33

2000 acid

5/10

Pump 54 bbls oil / 10 W 24 hrs.

5/18

"

5/25

"

6/1

"

6/8

Arb. 3345'

Lans. 3095'

5" @ 3346'

TD 3347'

Perf Lans

2000 acid

Pump 215 Oil / 19% W Pot

41-0 Gr.

Comp

COMPLETED

